


RECORD DRAWINGS

FOR THE

STAMFORD WATER POLLUTION CONTROL AUTHORITY

SOLIDS DRYING PROJECT

STAMFORD, CONNECTICUT

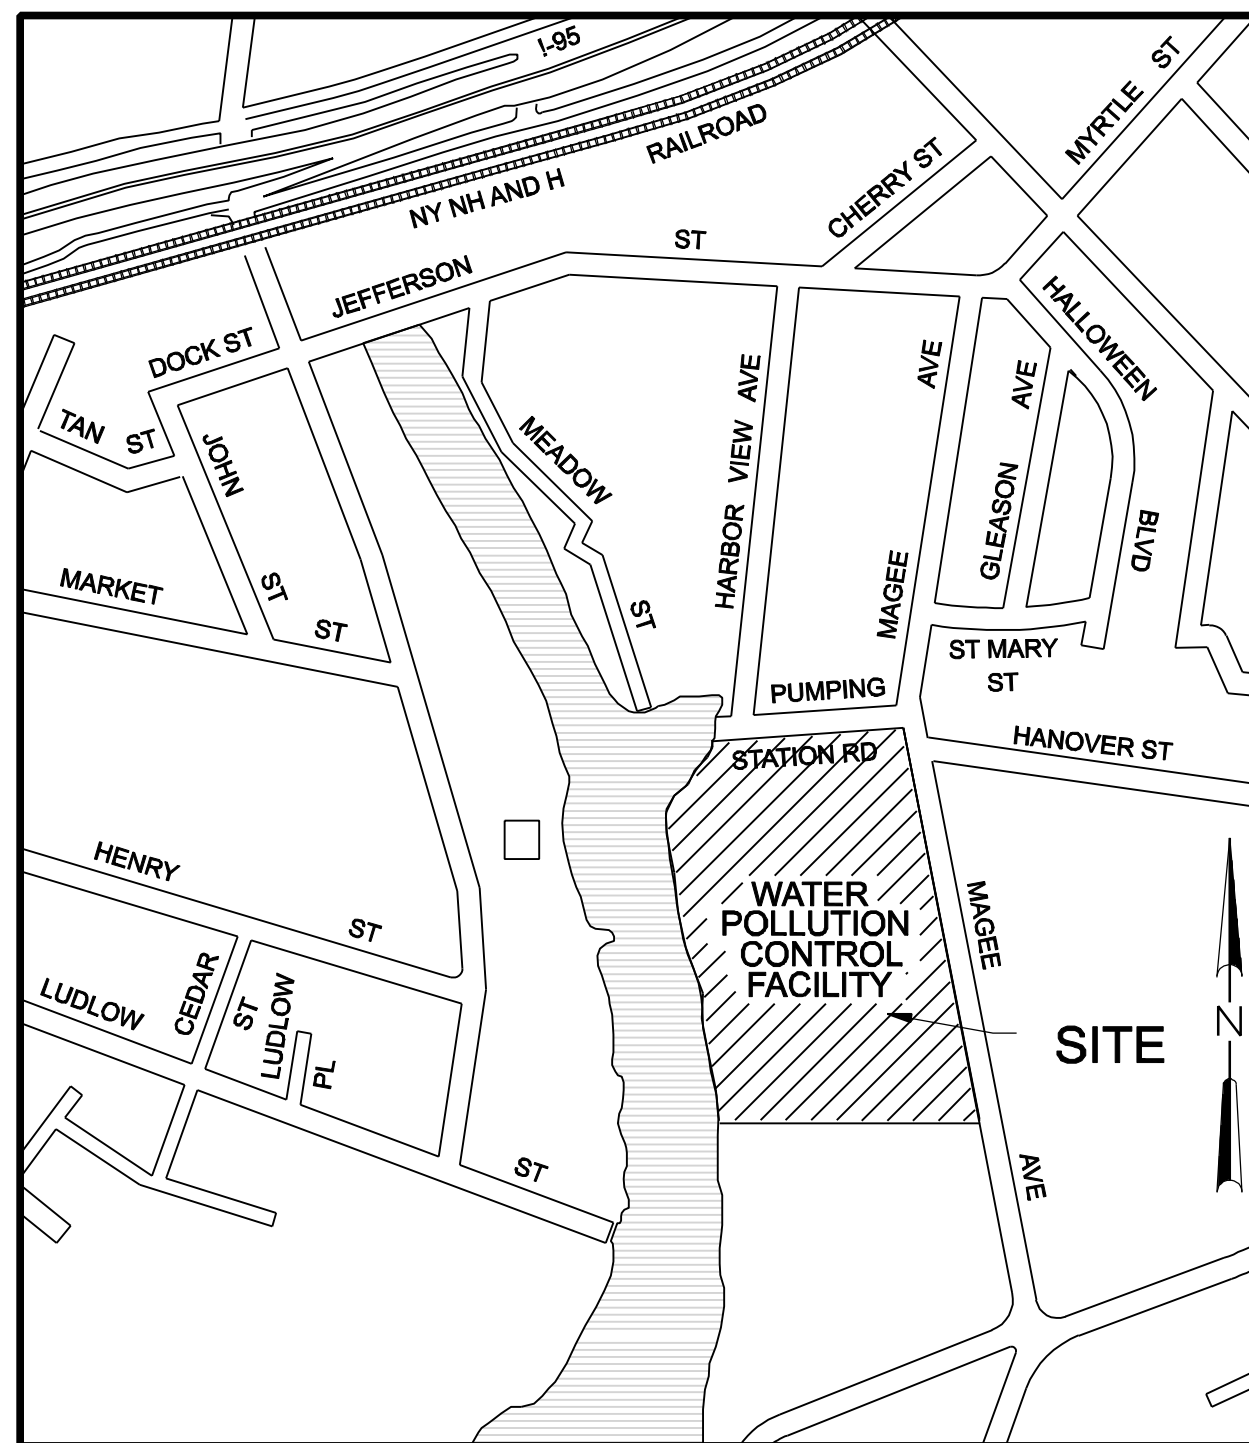

STAMFORD CONNECTICUT
LOCATION MAP
 NTS



99 CHERRY HILL ROAD, SUITE 200
 PARSIPPANY, NEW JERSEY
 SEPTEMBER 2006
 PROJECT 334058

_____ TIM CURTIN CHAIR WPCA
_____ JEANETTE A. BROWN, P.E., DEE EXECUTIVE DIRECTOR WPCA
_____ BRIAN GACKSTATTER, P.E. CH2M HILL
CITY OFFICIALS AND REPRESENTATIVES
MAYOR DANNEL P. MALLOY
PLANNING BOARD CHAIRPERSON DUANE HILL
BOARD OF FINANCE CHAIRPERSON MARY LOU RINALDI
BOARD OF REPRESENTATIVES PRESIDENT DAVID MARTIN