
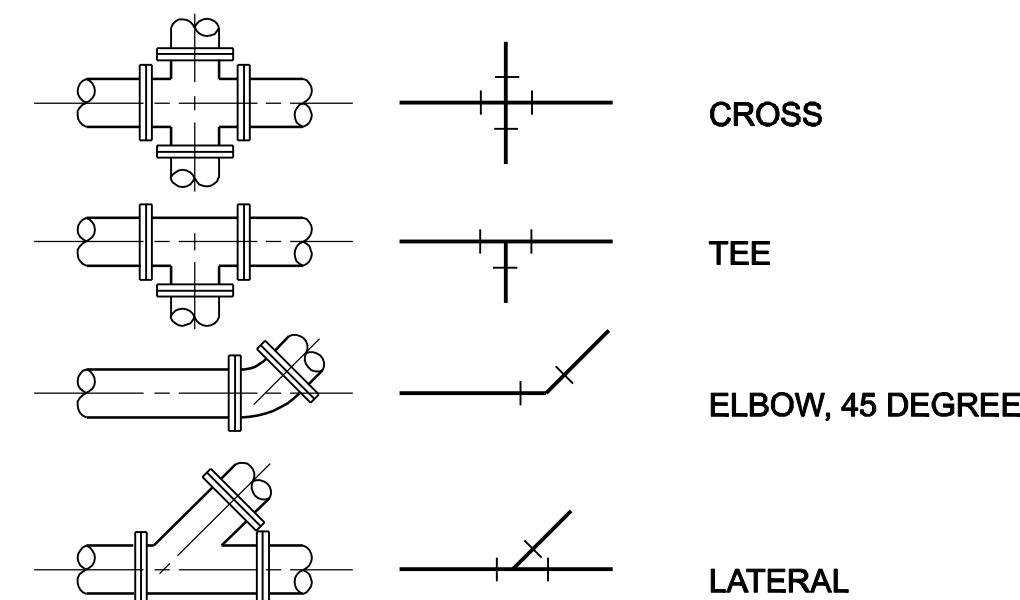


PIPE AND FITTING SYMBOLS


DOUBLE LINE

SINGLE LINE

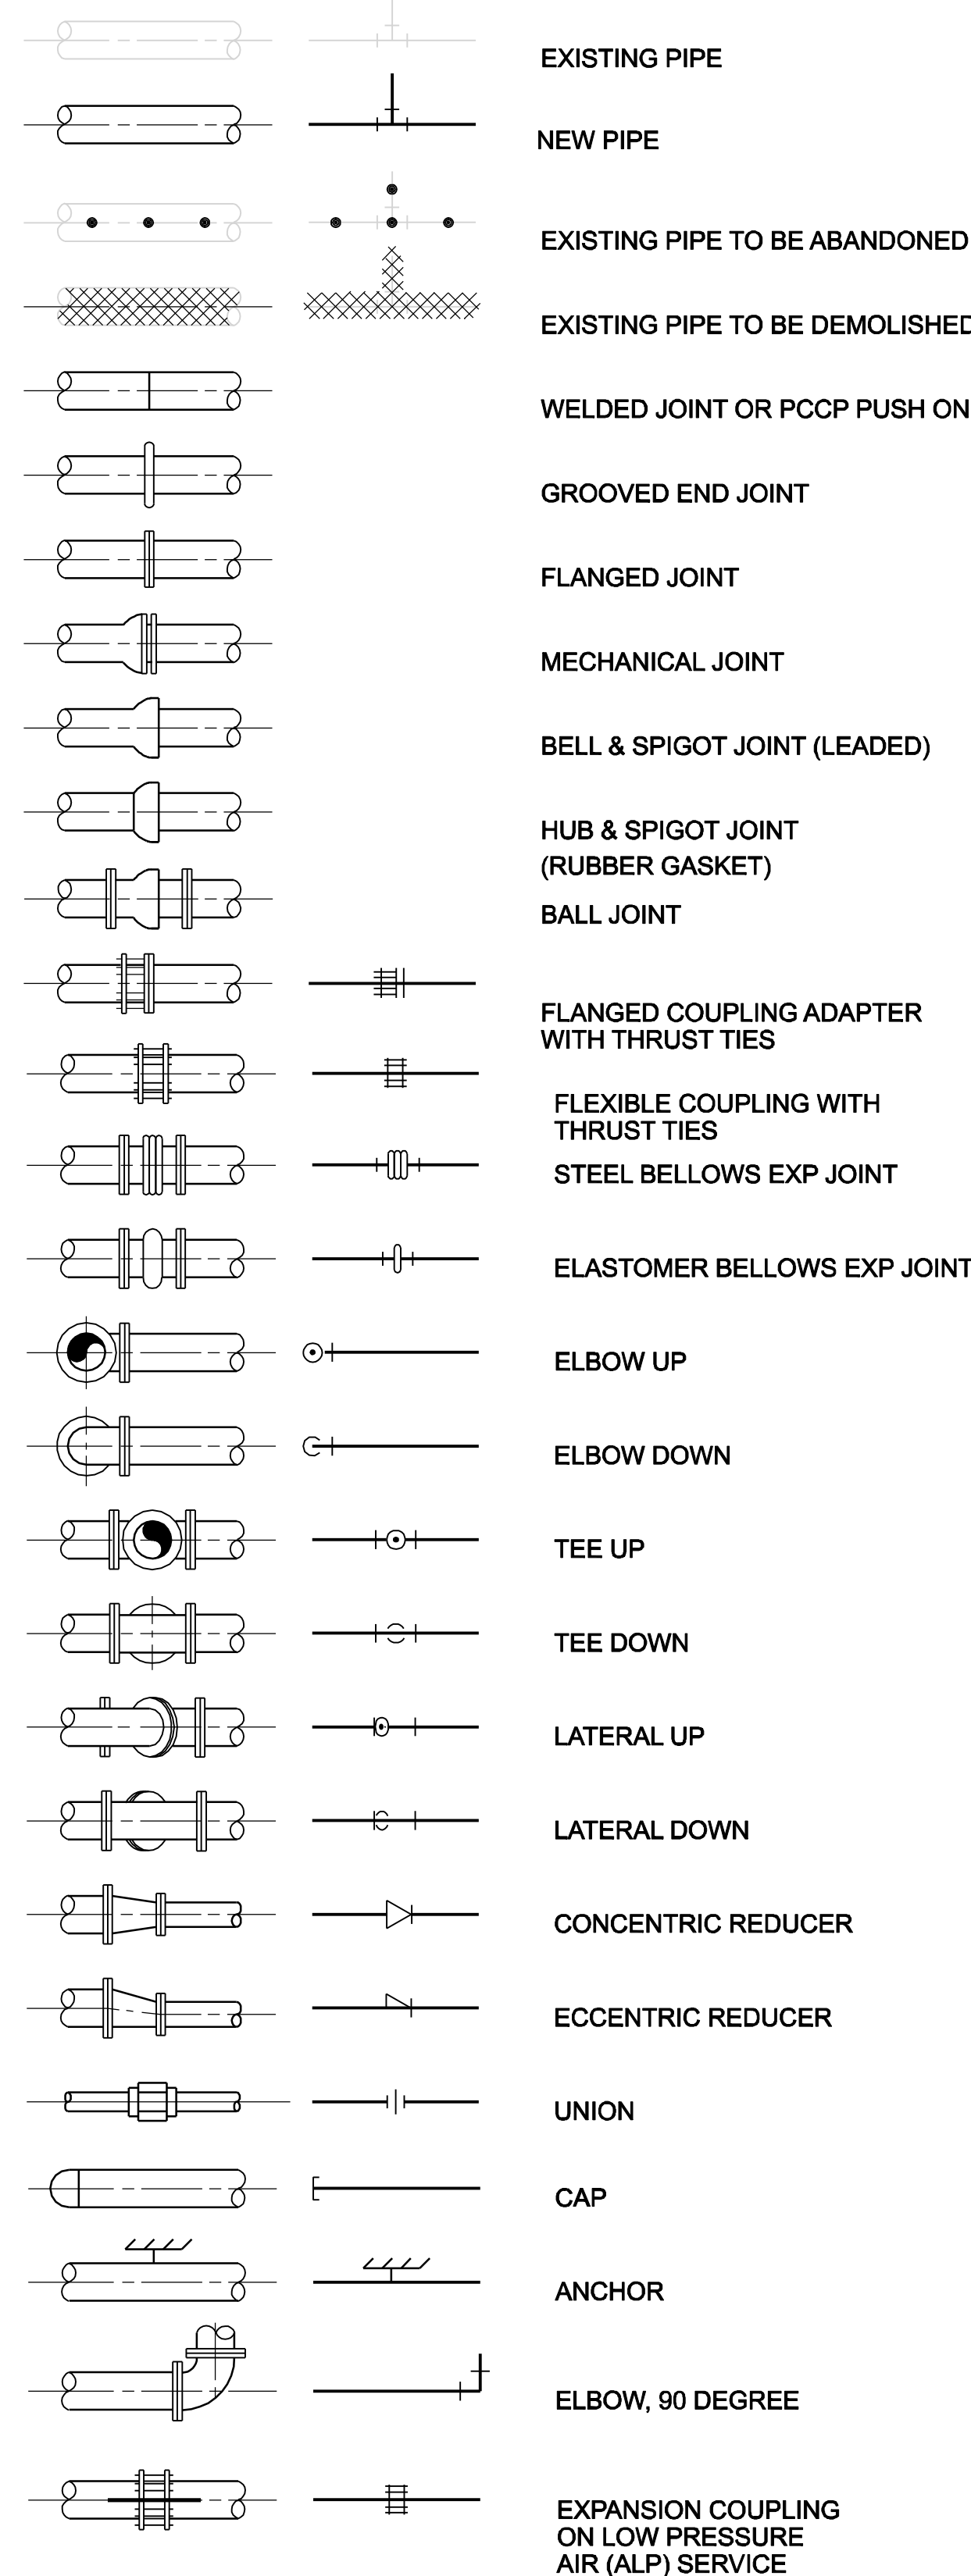


- NOTES:-**
- ONLY FLANGED END CONNECTIONS ARE SHOWN HERE FOR DOUBLE LINE FITTINGS. FITTINGS WITH OTHER END PATTERNS ARE SHOWN SIMILARLY ON THE CONSTRUCTION DRAWINGS. ALSO SEE PIPING SPECIFICATIONS.
 - SYMBOLS SHOWN HERE FOR SINGLE LINE FITTINGS ARE GENERIC ONLY. REFER TO PIPING SPECIFICATIONS FOR SPECIFIC END CONNECTIONS FOR SINGLE LINE PIPE AND FITTINGS.
 - EXISTING PIPE AND EQUIPMENT IS SHOWN LIGHT-LINED AND/OR SCREENED AND IS NOTED AS EXISTING, NEW PIPING AND EQUIPMENT IS SHOWN HEAVY-LINED.


YARD PIPING LEGEND

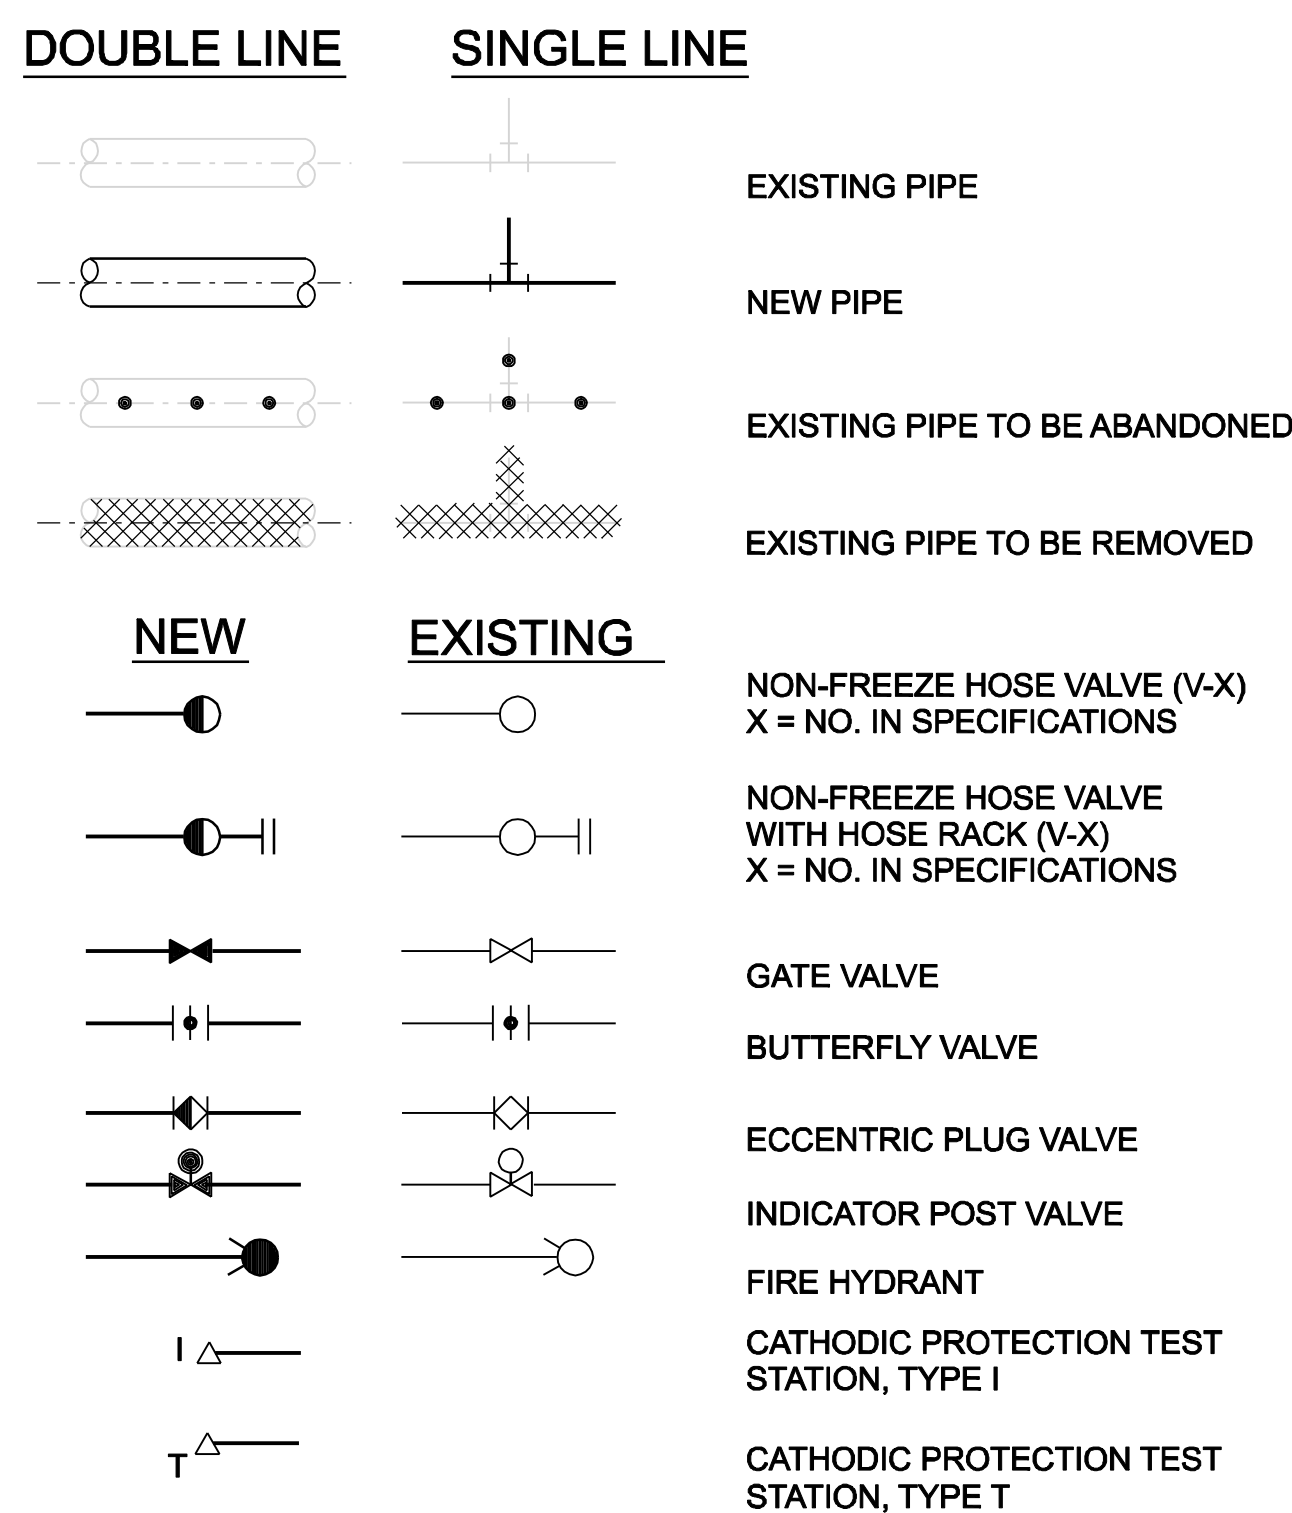


VALVE SYMBOLS

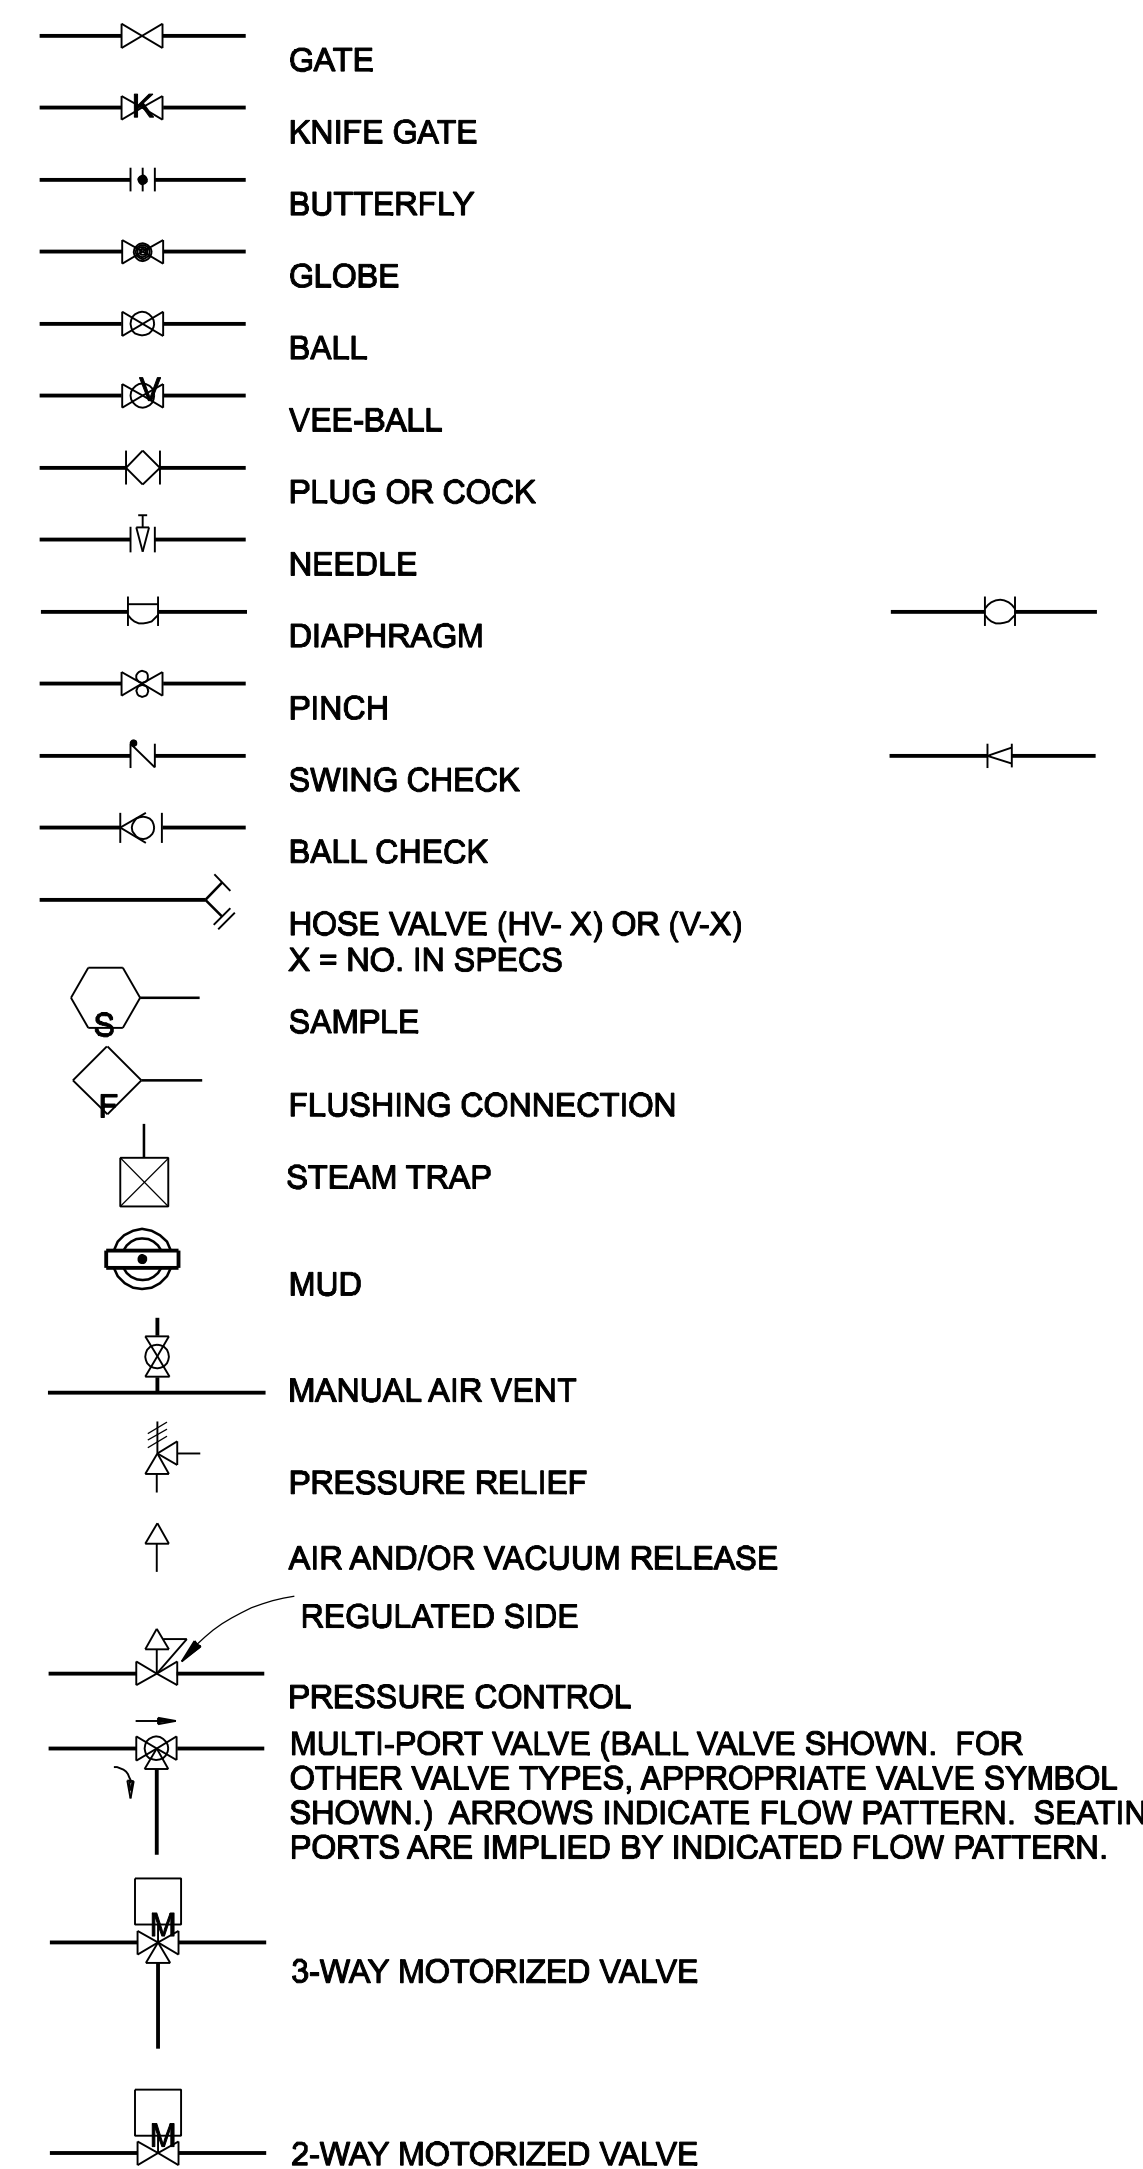

ALTERNATIVE

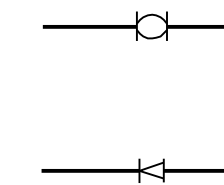


MISCELLANEOUS PIPING SYMBOLS

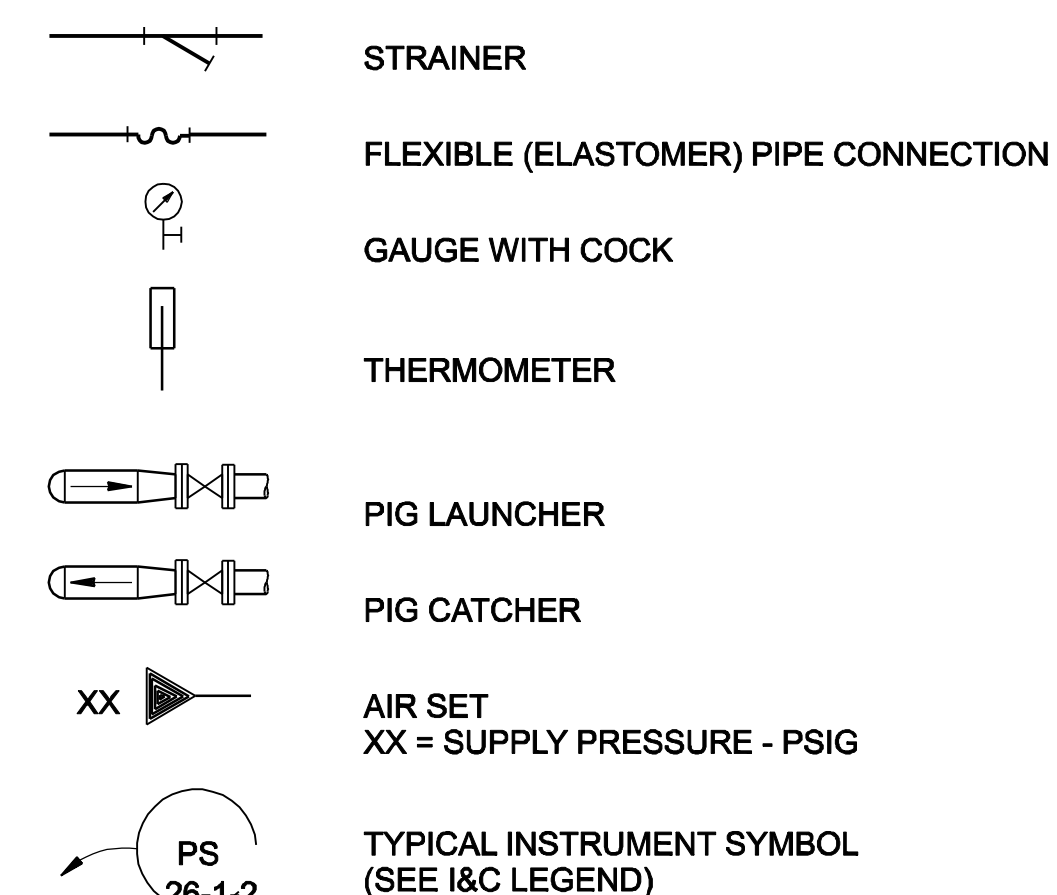


VALVE DESIGNATIONS


MANUAL VALVES AND CHECK VALVES

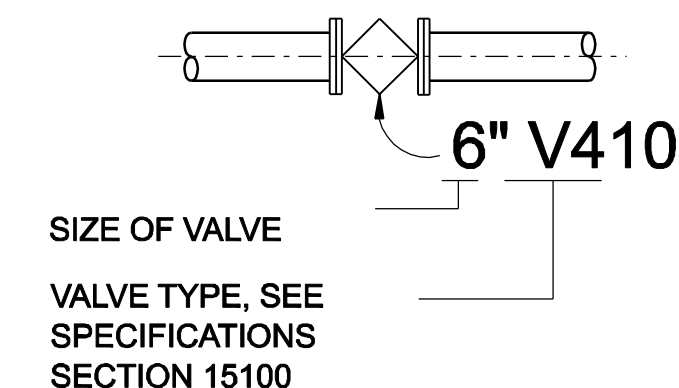

CONTROL VALVES

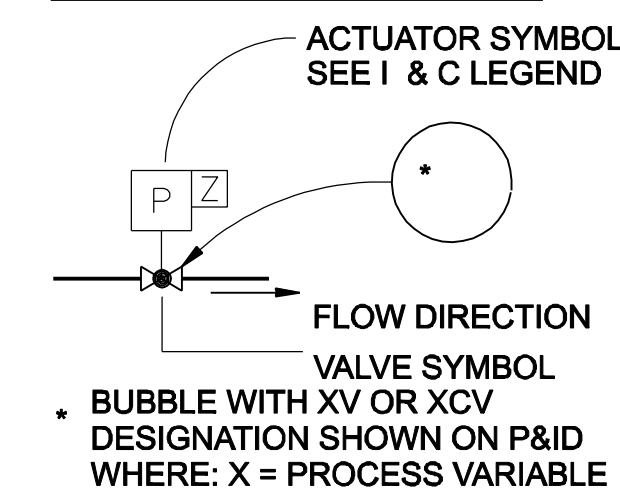

PIPING DESIGNATION

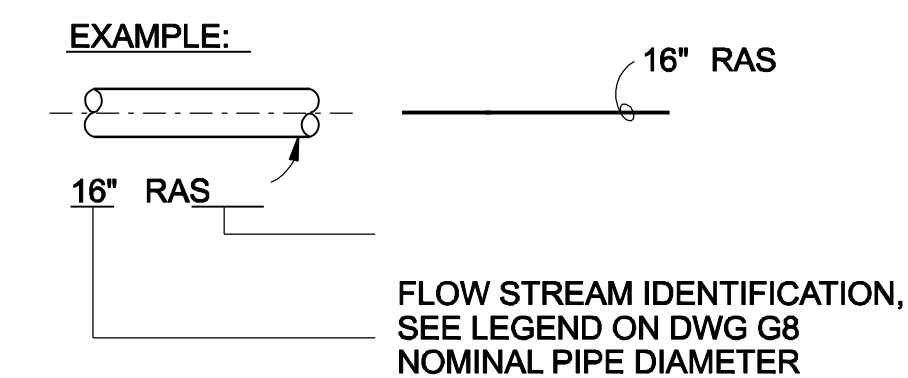

EQUIPMENT



THESE RECORD DOCUMENTS HAVE BEEN PREPARED BASED ON THE INFORMATION PROVIDED BY OTHERS. THE DESIGN PROFESSIONAL HAS NOT VERIFIED THE ACCURACY AND/OR COMPLETENESS OF THIS INFORMATION AND SHALL NOT BE RESPONSIBLE FOR ANY ERRORS OR OMISSIONS WHICH MAY BE INCORPORATED HEREIN AS A RESULT.

RECORD DRAWING RE-ISSUED FOR CONSTRUCTION ISSUED FOR CONSTRUCTION FOR FINAL REVIEW/ BUILDING PERMIT		BG	BG	PW	PW	APVD	B. GACKSTATTER
		BG	BG	BG	DL	BY	APVD
01/20/08	09/08/06	07/04/06	06/05/06	NO.	DATE	DR	S. LAROCQUE
3	2	1	0	D	NO.	DATE	P. SINGH
STAMFORD WPC STAMFORD WATER POLLUTION CONTROL AUTHORITY SOLIDS DRYING PROJECT		MECHANICAL MECHANICAL LEGEND (2)		VERIFY SCALE BAR IS ONE INCH ON ORIGINAL DRAWING.			
DATE: JUNE 2006 PROJ: 334058 DWG: G-8 SHEET: M1		FILENAME: stg008.334058.dgn MODIFIED DATE:		MODIFIED TIME:		REUSE OF DOCUMENTS: THIS DOCUMENT, AND THE IDEAS AND DESIGNS INCORPORATED HEREIN, AS AN INSTRUMENT OF PROFESSIONAL SERVICE, IS THE PROPERTY OF CH2M HILL AND IS NOT TO BE USED, IN WHOLE OR IN PART, FOR ANY OTHER PROJECT WITHOUT THE WRITTEN AUTHORIZATION OF CH2M HILL. © CH2M HILL 2004. ALL RIGHTS RESERVED.	