


1 2 3 4 5 6

A
B
C
D

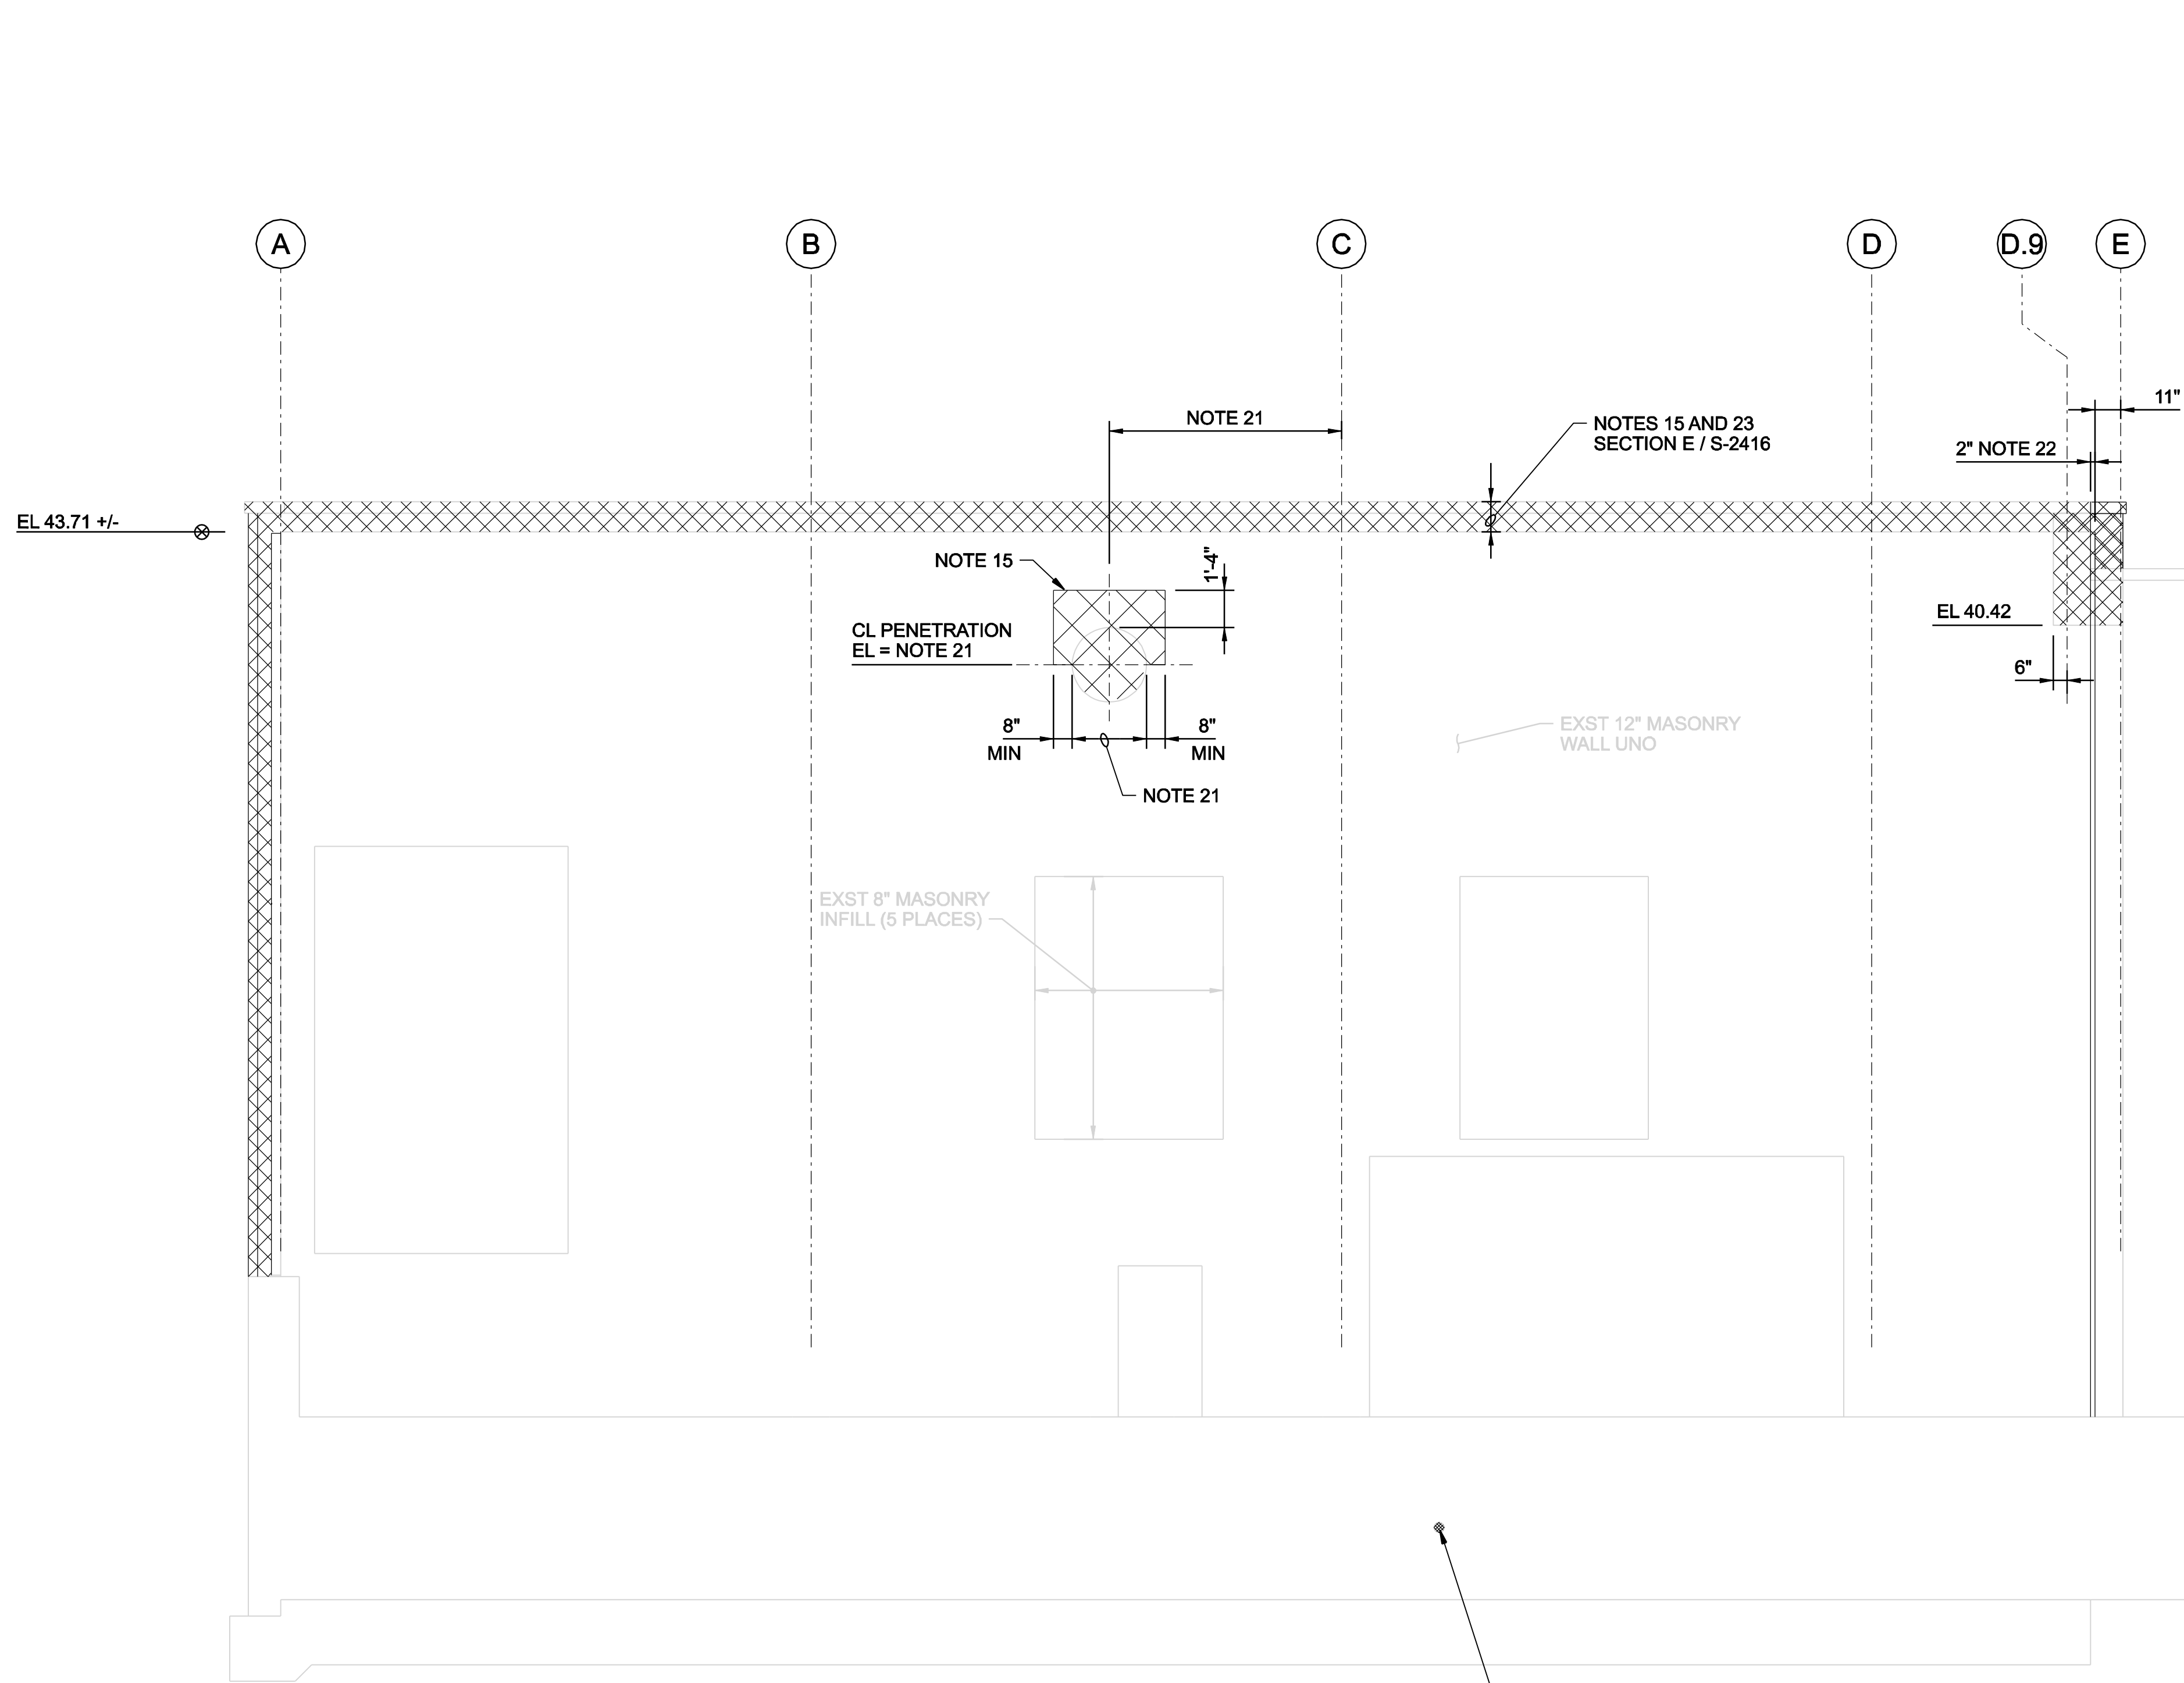

CONTRACTOR TO FIELD VERIFY ALL DIMENSIONS PRIOR TO INITIATING ANY DEMOLITION OR OTHER WORK INCLUDING ORDERING MATERIALS.

F SECTION
1/4"=1'-0"
SD-4

NOTES 14 AND 15
SEE MECHANICAL
DRAWINGS FOR
AS-BUILT LOCATIONS (3322-2)

- LEGEND:**
 INDICATES DEMOLISH ELEMENTS. SCALE OF HATCH MAY VARY TO DIFFERENTIATE BETWEEN DEMOLITION OF LARGER AND SMALLER ELEMENTS.
- NOTES:**
 SEE DRAWING SD-6 FOR NOTES 1 THROUGH 20.
 21. COORDINATE SIZE AND LOCATION OF PENETRATION WITH MECHANICAL AND / OR EQUIPMENT MFG.
 22. CUT 2" JOINT THROUGH MASONRY WALL.
 23. REMOVE EXISTING COPING AND STORE FOR REUSE.

THESE RECORD DOCUMENTS HAVE BEEN PREPARED BASED ON THE INFORMATION PROVIDED BY OTHERS. THE DESIGN PROFESSIONAL HAS NOT VERIFIED THE ACCURACY AND/OR COMPLETENESS OF THIS INFORMATION AND SHALL NOT BE RESPONSIBLE FOR ANY ERRORS OR OMISSIONS WHICH MAY BE INCORPORATED HEREIN AS A RESULT.

| | | | | | | |
|--|--|--|-------------|----------------------------|----------------------------|---|
| STAMFORD WATER POLLUTION CONTROL AUTHORITY SOLIDS DRYING PROJECT | | RECORD DRAWING RE-ISSUED FOR CONSTRUCTION ISSUED FOR CONSTRUCTION FOR FINAL REVIEW/ BUILDING PERMIT | | BG BG BG MC BY | BG PW BG BG BG | APVD APVD APVD APVD APVD |
| | | 01/20/08 09/09/06 07/04/06 06/19/06 | DSGN NO. | DATE | DR REVISION | M. CHEZANOWSKI A. CHADHA M. GOODSON B. GACKSTATTER |
| CH2MHILL STRUCTURAL DEMOLITION SECTION ALONG COLUMN LINE 5 | | REUSE OF DOCUMENTS: THIS DOCUMENT AND THE IDEAS AND DESIGNS INCORPORATED HEREIN, AS AN INSTRUMENT OF PROFESSIONAL SERVICE, IS THE PROPERTY OF CH2M HILL AND IS NOT TO BE USED, IN WHOLE OR IN PART, FOR ANY OTHER PROJECT WITHOUT THE WRITTEN AUTHORIZATION OF CH2M HILL. © CH2M HILL 2004. ALL RIGHTS RESERVED. | | | | |
| VERIFY SCALE BAR IS ONE INCH ON ORIGINAL DRAWING. | | DATE: JUNE 2006 PROJ: 334058 DWG: SD-12 SHEET: S11 | | | | |