


- NOTES:**
- SUB CONTRACTOR TO PERFORM CCTV INSPECTION WITH THE OWNER FOR THE EXISTING 10"SS AND THE EXISTING MANHOLE. REHABILITATION, IF ANY, WILL BE COMPLETED AFTER CCTV INSPECTION HAS BEEN PERFORMED.
  - SLOPE PAVEMENT TO MATCH DOOR THRESHOLD EL 18.08. COORDINATE WITH ARCHITECTURAL AND STRUCTURAL DRAWINGS.
  - SUB CONTRACTOR TO PERFORM EXCAVATION, BACKFILLING AND FINAL PAVING FOR THE INSTALLATION OF THE 6" NATURAL GAS LINE.
  - NEW ASPHALT PAVEMENT SHALL BE CONNECTED TO EXISTING PAVEMENT PER DETAIL 2005
  - SUB CONTRACTOR TO PROVIDE ASPHALT PAVEMENT PER CITY OF STAMFORD DETAIL 2002

THESE RECORD DOCUMENTS HAVE BEEN PREPARED BASED ON THE INFORMATION PROVIDED BY OTHERS. THE DESIGN PROFESSIONAL HAS NOT VERIFIED THE ACCURACY AND/OR COMPLETENESS OF THIS INFORMATION AND SHALL NOT BE RESPONSIBLE FOR ANY ERRORS OR OMISSIONS WHICH MAY BE INCORPORATED HEREIN AS A RESULT.



7	02/01/08	RECORD DRAWING	BG	BG
6	07/30/07	REVISIONS PER CCIR No. (DR-21)	BG	BG
5	11/29/06	REVISIONS PER CCIR No. (DR-8)	BG	BG
4	10/31/06	REVISIONS PER CCIR No. (DR-6)	BG	BG
3	09/08/06	RE-ISSUED FOR CONSTRUCTION	BG	BG
2	06/12/06	ENGINEERING DEPARTMENT COMMENTS	BG	BG
1	07/04/06	ISSUED FOR CONSTRUCTION	BG	BG
0	06/05/06	FOR FINAL REVIEW/ BUILDING PERMIT	BG	BG
NO.	DATE	REVISION	BY	APVD
			DR	APVD
			CHK	APVD
			D. MISSIG	B. GACKSTATTER
			A. RIOLO	B. GACKSTATTER
				B. GACKSTATTER

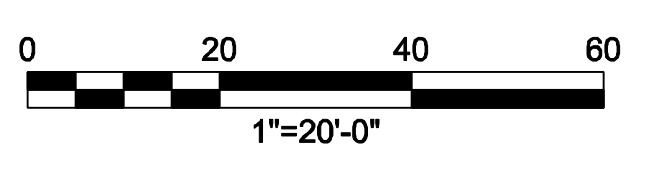

**CH2MHILL**

STAMFORD WATER POLLUTION CONTROL AUTHORITY  
SOLIDS DRYING PROJECT

CIVIL  
SITE PLAN

VERIFY SCALE	
BAR IS ONE INCH ON ORIGINAL DRAWING.	
DATE	JUNE 2006
PROJ	334058
DWG	C-2401
SHEET	C2

REUSE OF DOCUMENTS: THIS DOCUMENT AND THE IDEAS AND DESIGNS INCORPORATED HEREIN, AS AN INSTRUMENT OF PROFESSIONAL SERVICE, IS THE PROPERTY OF CH2M HILL AND IS NOT TO BE USED, IN WHOLE OR IN PART, FOR ANY OTHER PROJECT WITHOUT THE WRITTEN AUTHORIZATION OF CH2M HILL. © CH2M HILL 2004. ALL RIGHTS RESERVED.