


1 2 3 4 5 6

A
B
C
D

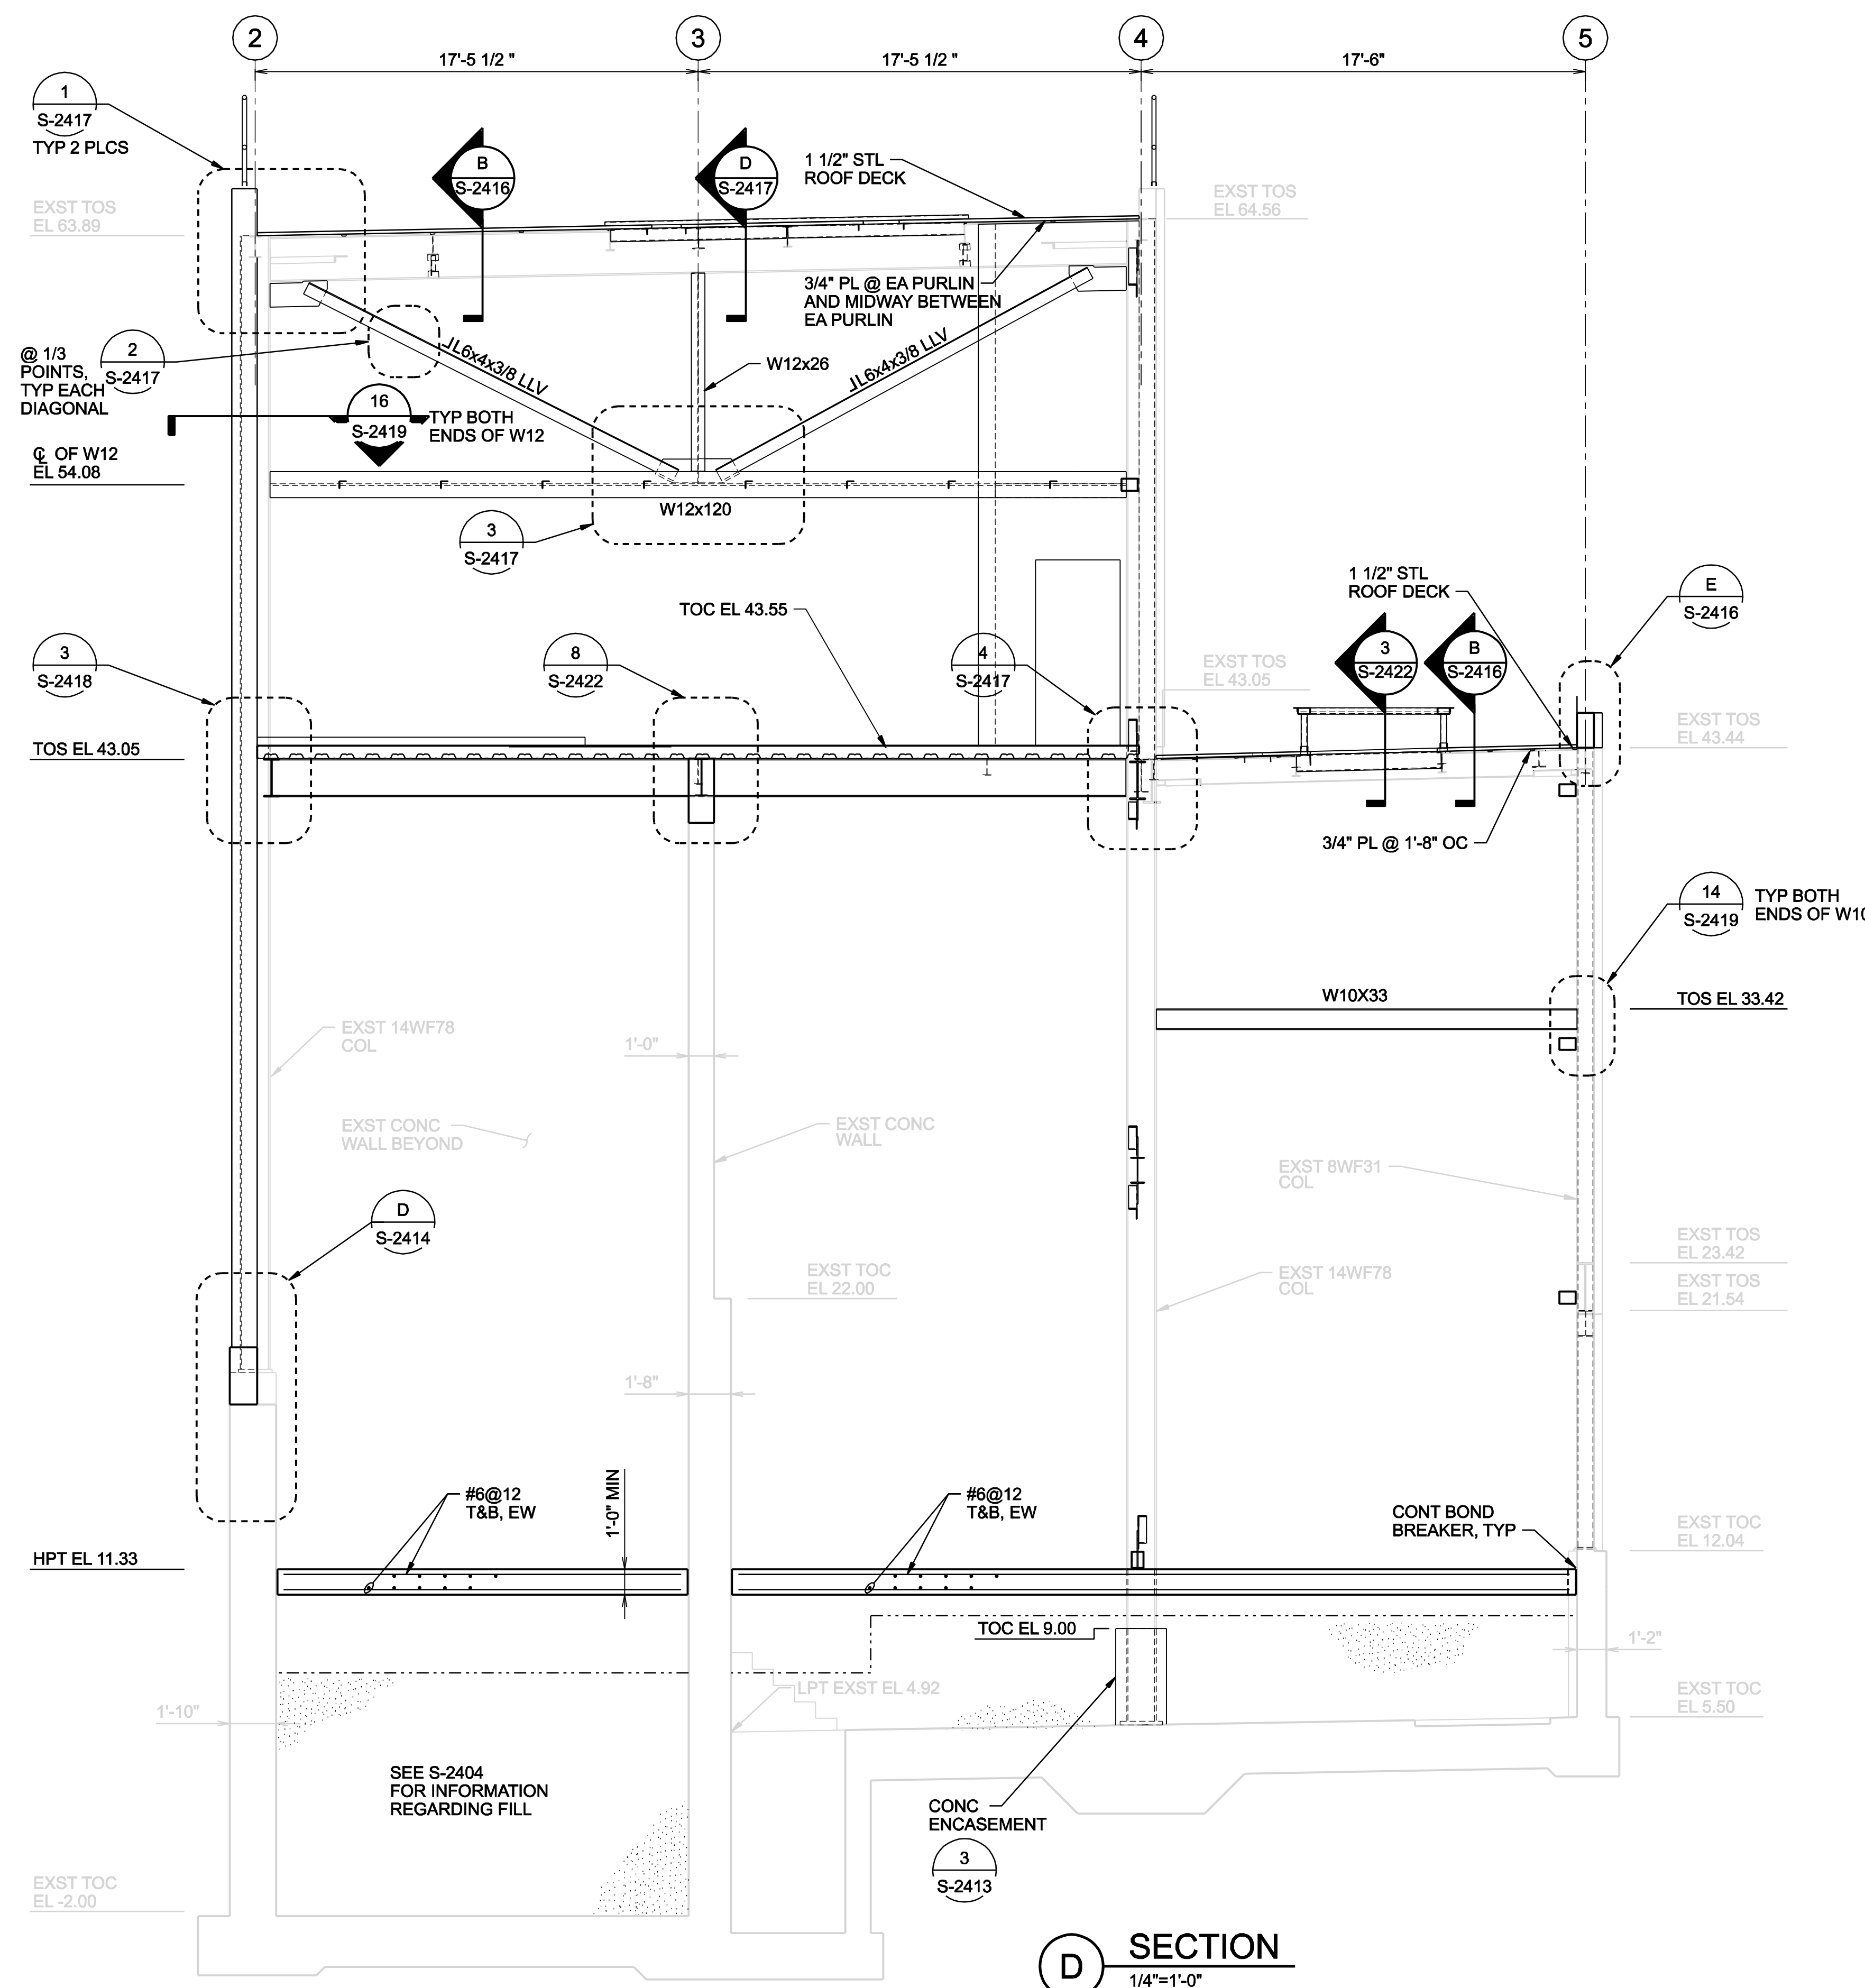

CONTRACTOR TO FIELD VERIFY ALL DIMENSIONS PRIOR TO INITIATING ANY DEMOLITION OR OTHER WORK INCLUDING ORDERING MATERIALS.

D SECTION
1/4"=1'-0"

S-2400, S-2401
S-2402

THESE RECORD DOCUMENTS HAVE BEEN PREPARED BASED ON THE INFORMATION PROVIDED BY OTHERS. THE DESIGN PROFESSIONAL HAS NOT VERIFIED THE ACCURACY AND/OR COMPLETENESS OF THIS INFORMATION AND SHALL NOT BE RESPONSIBLE FOR ANY ERRORS OR OMISSIONS WHICH MAY BE INCORPORATED HEREIN AS A RESULT.

RECORD DRAWING		DR	CHK	APVD
RE-ISSUED FOR CONSTRUCTION				
ISSUED FOR CONSTRUCTION				
FOR FINAL REVIEW/ BUILDING PERMIT				
NO.	DATE	NO.	DATE	NO.
3	01/20/08	2	09/08/06	1
2	09/08/06	1	07/04/06	0
1	07/04/06	0	06/19/06	
DGN		DR		APVD
M. CHEZANOWSKI		G. OMORI		B. GACKSTATTER
M. GOODSON		M. GOODSON		B. GACKSTATTER
<small>REUSE OF DOCUMENTS: THIS DOCUMENT AND THE IDEAS AND DESIGNS INCORPORATED HEREIN, AS AN INSTRUMENT OF PROFESSIONAL SERVICE, IS THE PROPERTY OF CH2M HILL AND IS NOT TO BE USED, IN WHOLE OR IN PART, FOR ANY OTHER PROJECT WITHOUT THE WRITTEN AUTHORIZATION OF CH2M HILL. © CH2M HILL 2004. ALL RIGHTS RESERVED.</small>				
STAMFORD WATER POLLUTION CONTROL AUTHORITY SOLIDS DRYING PROJECT				
CH2MHILL				
STRUCTURAL SECTION				
VERIFY SCALE				
BAR IS ONE INCH ON ORIGINAL DRAWING.				
DATE	JUNE 2006			
PROJ	334058			
DWG	S-2406			
SHEET	S19			