
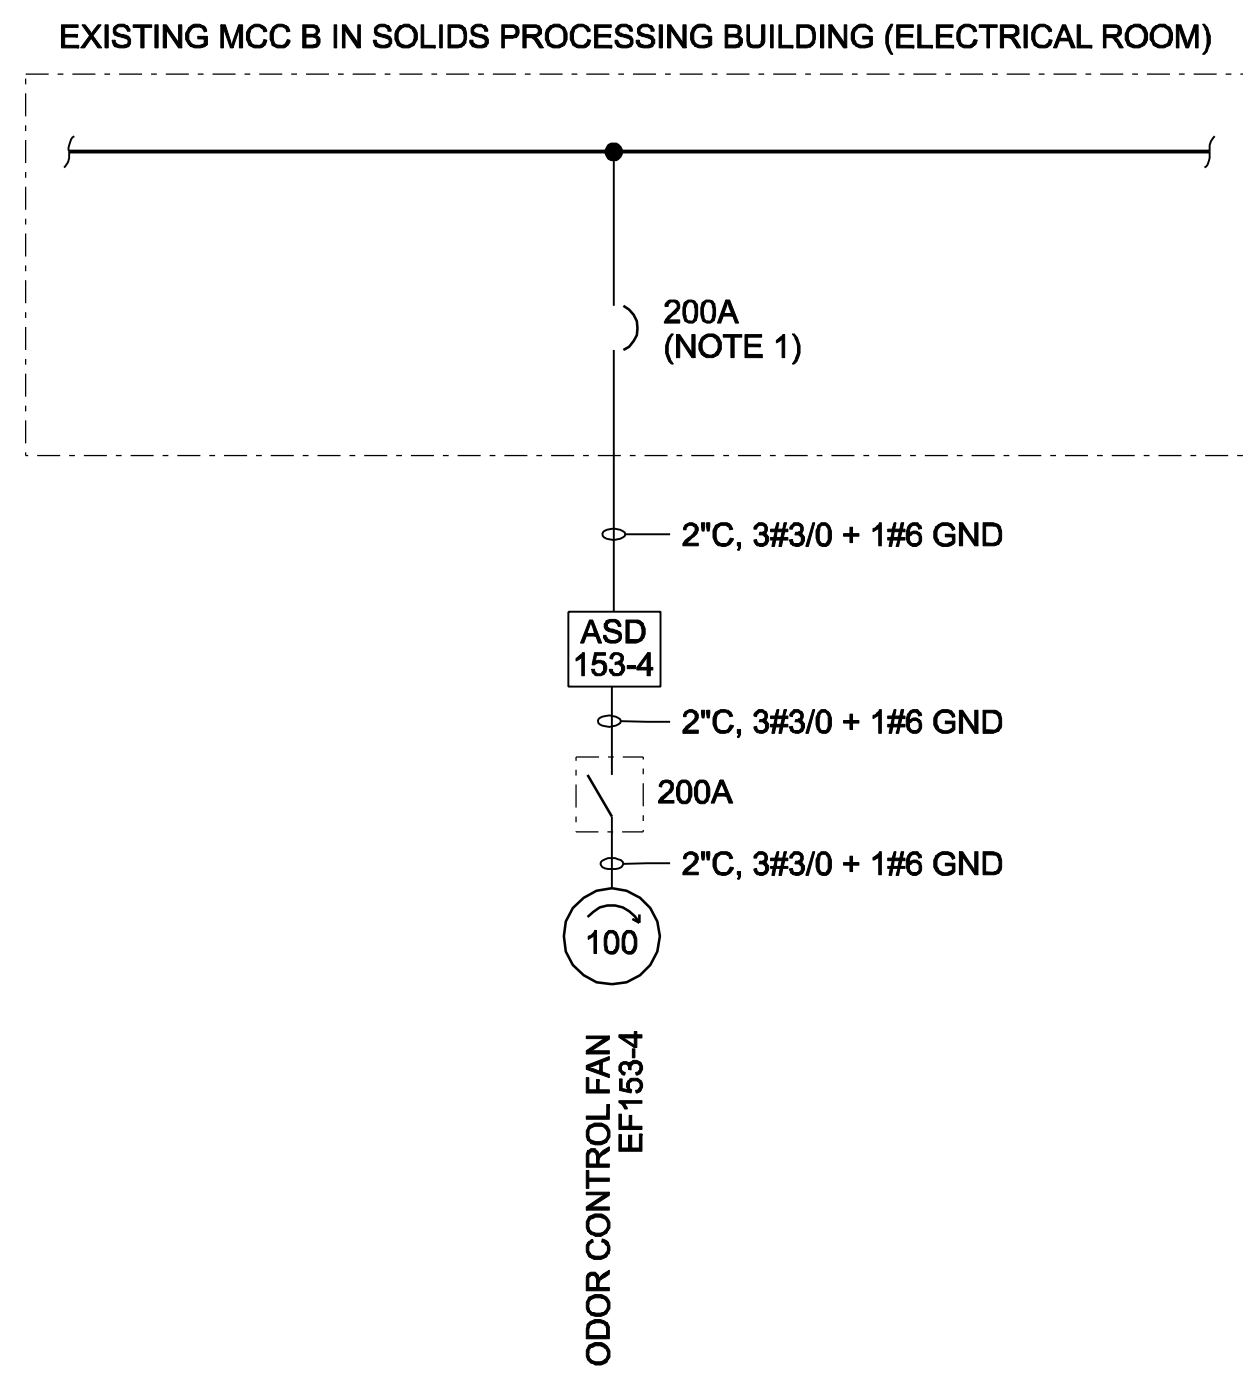


A
B
C
D

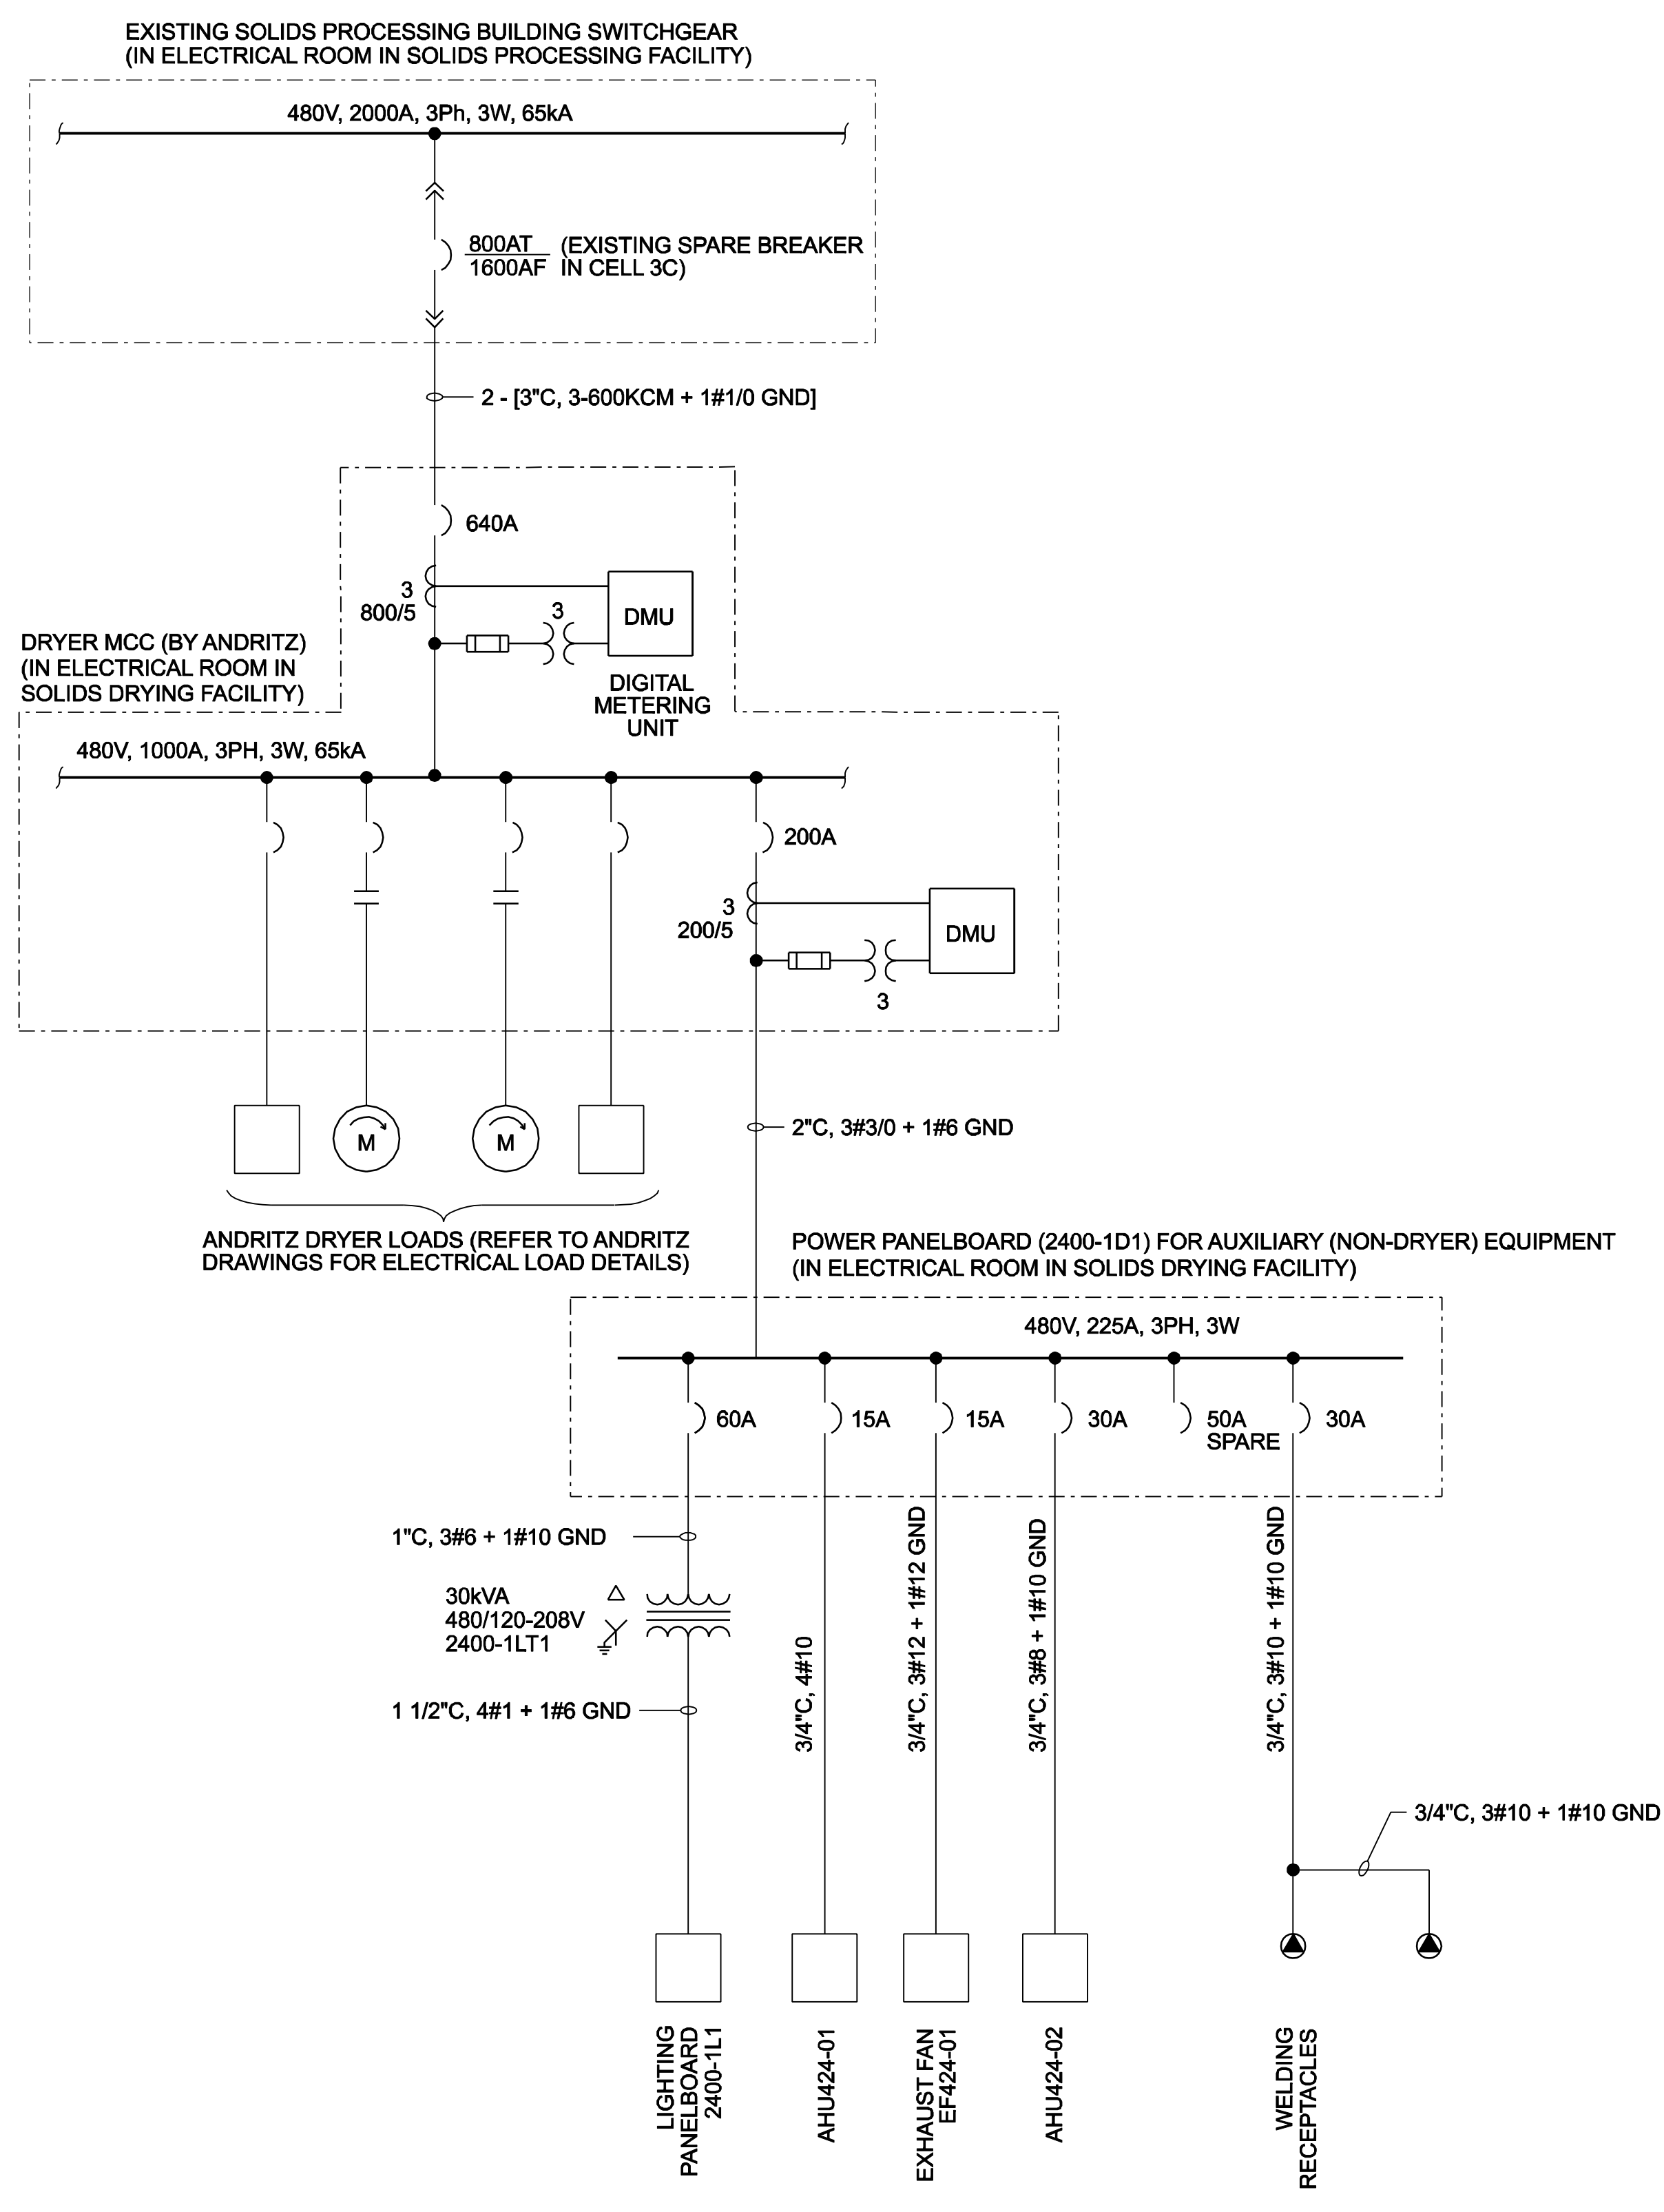

NOTE:
1. PROVIDE AND INSTALL 200A, 480V, 3PH, 65kA BREAKER IN EXISTING SPACE OF UNIT 8J

THESE RECORD DOCUMENTS HAVE BEEN PREPARED BASED ON THE INFORMATION PROVIDED BY OTHERS. THE DESIGN PROFESSIONAL HAS NOT VERIFIED THE ACCURACY AND/OR COMPLETENESS OF THIS INFORMATION AND SHALL NOT BE RESPONSIBLE FOR ANY ERRORS OR OMISSIONS WHICH MAY BE INCORPORATED HEREIN AS A RESULT.

		RECORD DRAWING		B GACKSTATTER																										
		RE-ISSUED FOR CONSTRUCTION		D DOAR																										
STAMFORD WATER POLLUTION CONTROL AUTHORITY SOLIDS DRYING PROJECT		ISSUED FOR CONSTRUCTION		N CLERK																										
		FOR FINAL REVIEW/ BUILDING PERMIT		DR																										
<table border="1"> <tr> <th>NO.</th> <th>DATE</th> <th>REVISION</th> <th>BY</th> <th>APVD</th> </tr> <tr> <td>3</td> <td>01/20/08</td> <td></td> <td></td> <td></td> </tr> <tr> <td>2</td> <td>09/08/06</td> <td></td> <td></td> <td></td> </tr> <tr> <td>1</td> <td>07/04/06</td> <td></td> <td></td> <td></td> </tr> <tr> <td>0</td> <td>06/05/06</td> <td></td> <td></td> <td></td> </tr> </table>		NO.	DATE	REVISION	BY	APVD	3	01/20/08				2	09/08/06				1	07/04/06				0	06/05/06				D DDOAR		B GACKSTATTER	
NO.	DATE	REVISION	BY	APVD																										
3	01/20/08																													
2	09/08/06																													
1	07/04/06																													
0	06/05/06																													
		ELECTRICAL MAIN ONE LINE DIAGRAM		© CH2M HILL 2004. ALL RIGHTS RESERVED. REUSE OF DOCUMENTS: THIS DOCUMENT AND THE IDEAS AND DESIGNS INCORPORATED HEREIN, AS AN INSTRUMENT OF PROFESSIONAL SERVICE, IS THE PROPERTY OF CH2M HILL AND IS NOT TO BE USED, IN WHOLE OR IN PART, FOR ANY OTHER PROJECT WITHOUT THE WRITTEN AUTHORIZATION OF CH2M HILL.																										
VERIFY SCALE BAR IS ONE INCH ON ORIGINAL DRAWING.		DATE: JUNE 2006		PROJECT: 334058																										
		DWG: E-2401		SHEET: E3																										