


**STAMFORD WATER POLLUTION CONTROL FACILITY
 SLUDGE DRYING FACILITY
 ONE HARBORVIEW AVE
 STAMFORD
 DATE 2/19/07**

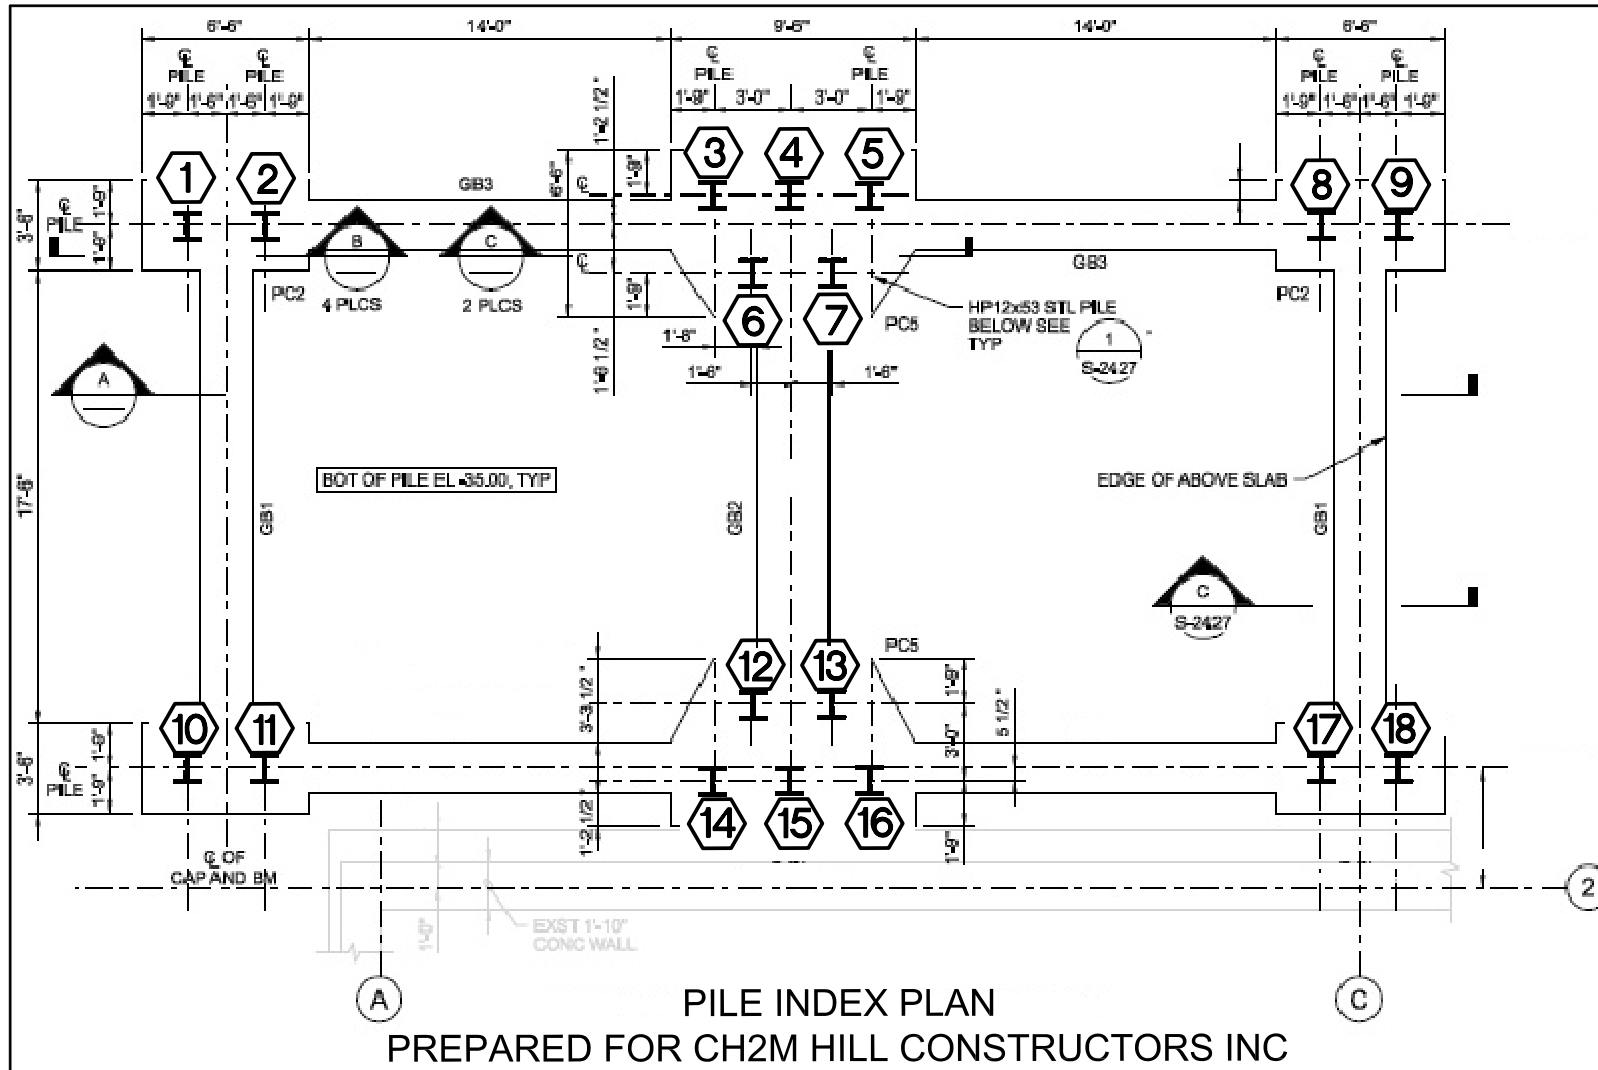

Prepared by,
BOLDUC LAND CONSULTANTS, LLC
 1237 East Main Street
 Meriden, Connecticut 06450
 Tel: 203-440-1746



18 PILE NUMBER (TYP)

NOT TO SCALE

**STAMFORD WATER POLLUTION CONTROL FACILITY
 SLUDGE DRYING FACILITY
 ONE HARBORVIEW AVE
 STAMFORD
 DATE 2/19/07**



GRID AS ESTABLISHED ON EXISTING COLUMNS

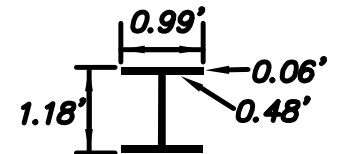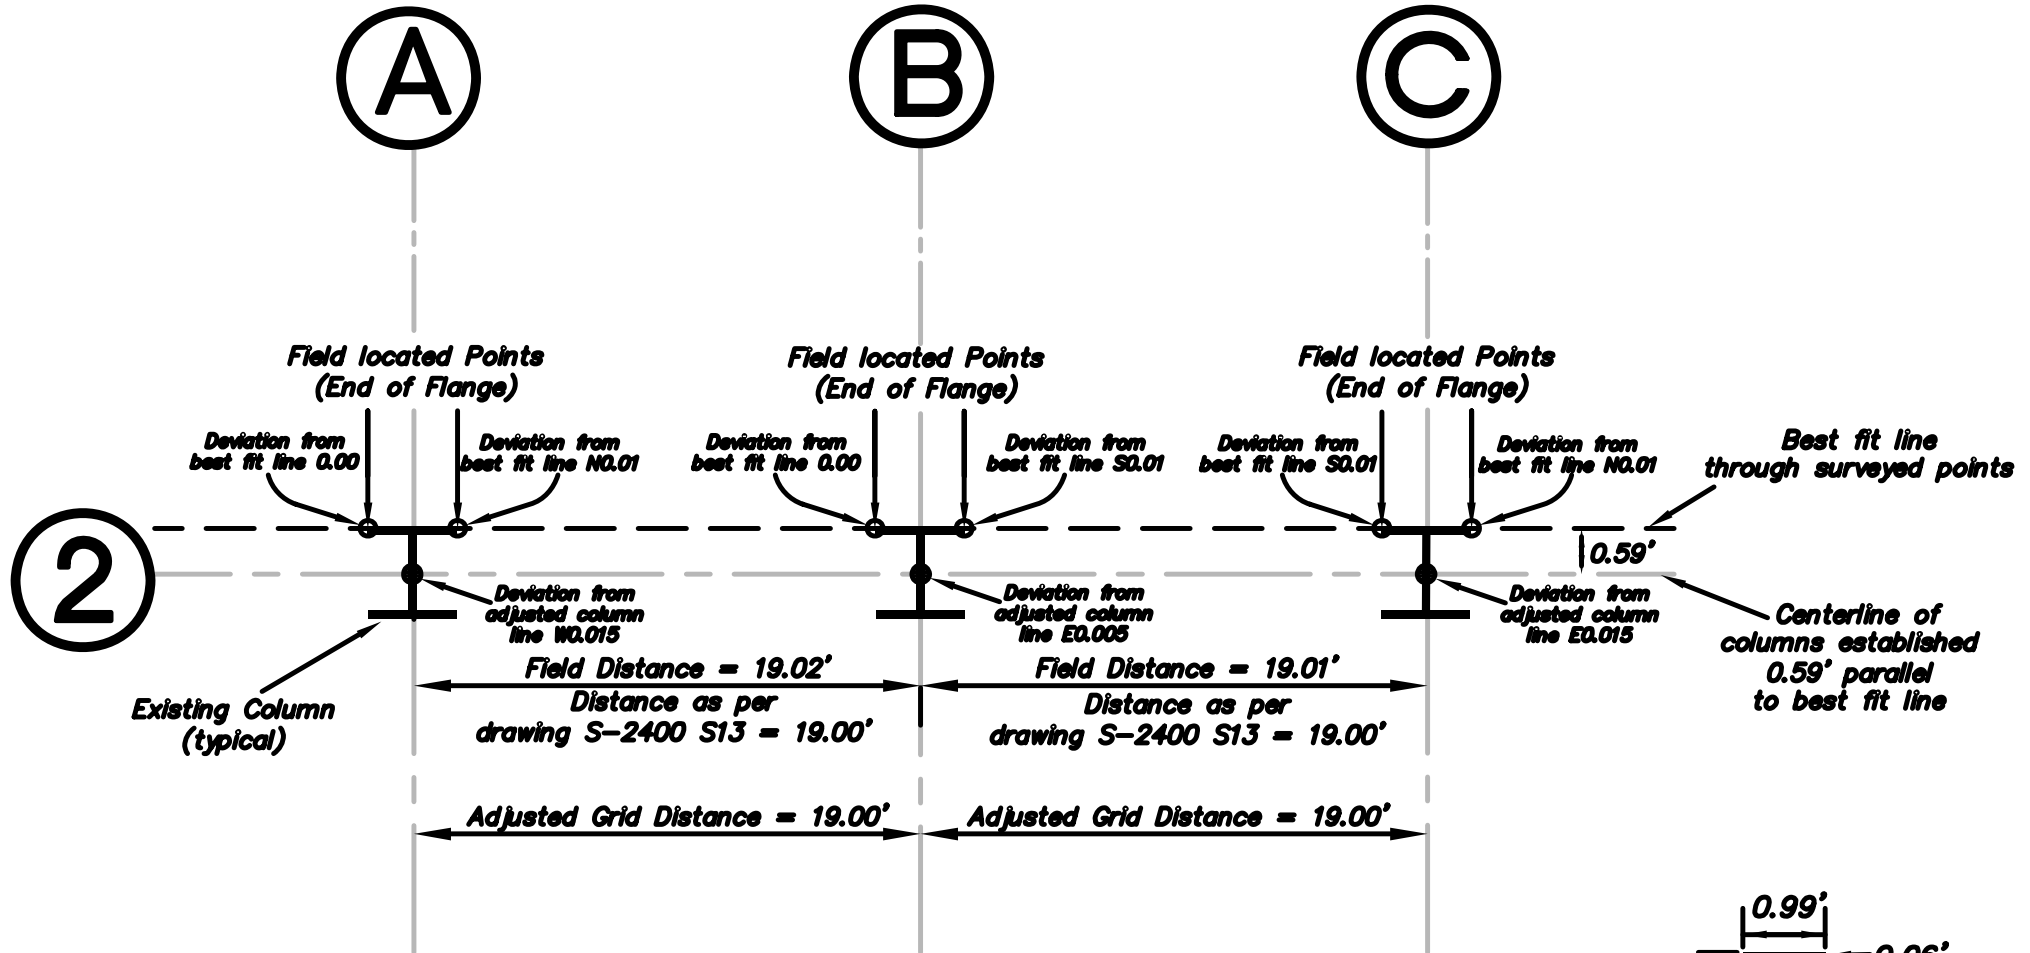

Prepared by,
BOLDUC LAND CONSULTANTS, LLC
 1237 East Main Street
 Meriden, Connecticut 06450
 Tel: 203-440-1746


GRID ESTABLISHMENT AS UTILIZED
 FOR PILE OFFSETS TO BE
 REVIEWED AND APPROVED BY CH2M HILL

NOT TO SCALE

SHEET 2 OF 20

**STAMFORD WATER POLLUTION CONTROL FACILITY
 SLUDGE DRYING FACILITY
 ONE HARBORVIEW AVE
 STAMFORD**

**PILE LOCATION. DATE 2/19/07
 PREPARED FOR CH2M HILL CONSTRUCTORS, INC.**

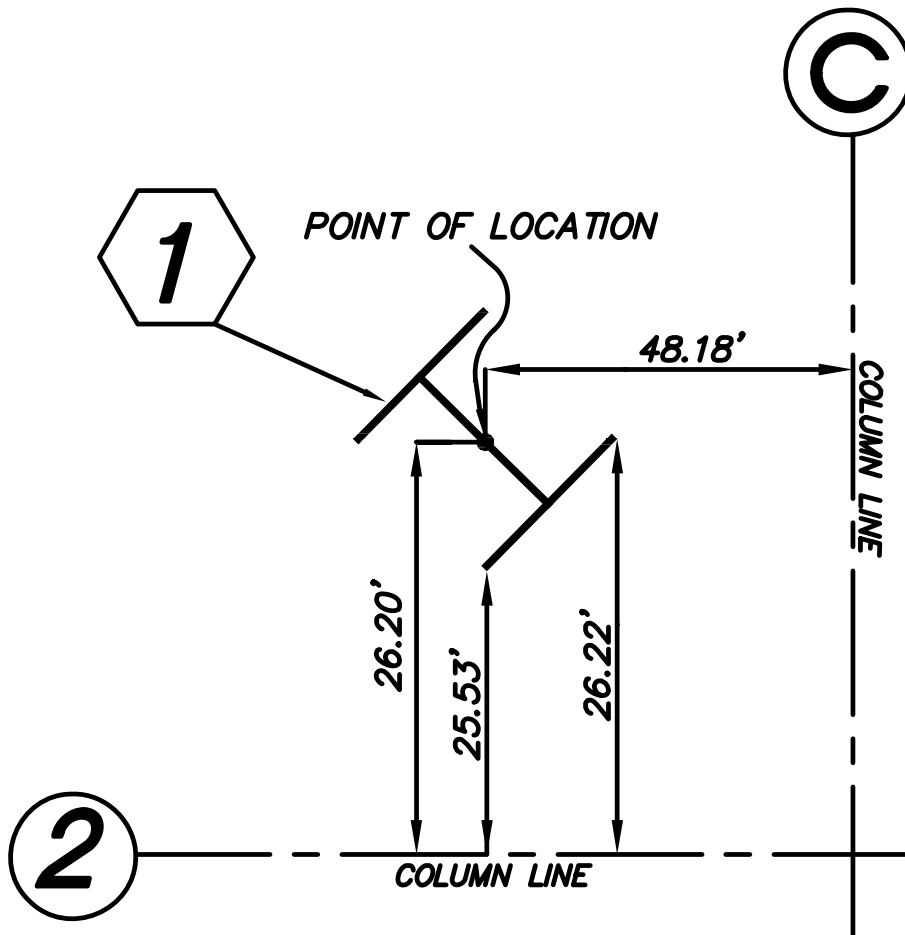

1 PILE NUMBER (TYP)

C COLUMN LINE (TYP)

Prepared by,
BOLDUC LAND CONSULTANTS, LLC
 1237 East Main Street
 Meriden, Connecticut 06450
 Tel: 203-440-1746

PILE 1 LOCATION


10297.34 NORTHING (Y)
 19932.11 EASTING (X)
 12.41 ELEVATION (Z)

NOT TO SCALE

SHEET 3 OF 20

**STAMFORD WATER POLLUTION CONTROL FACILITY
 SLUDGE DRYING FACILITY
 ONE HARBORVIEW AVE
 STAMFORD**

**PILE LOCATION. DATE 2/19/07
 PREPARED FOR CH2M HILL CONSTRUCTORS, INC.**

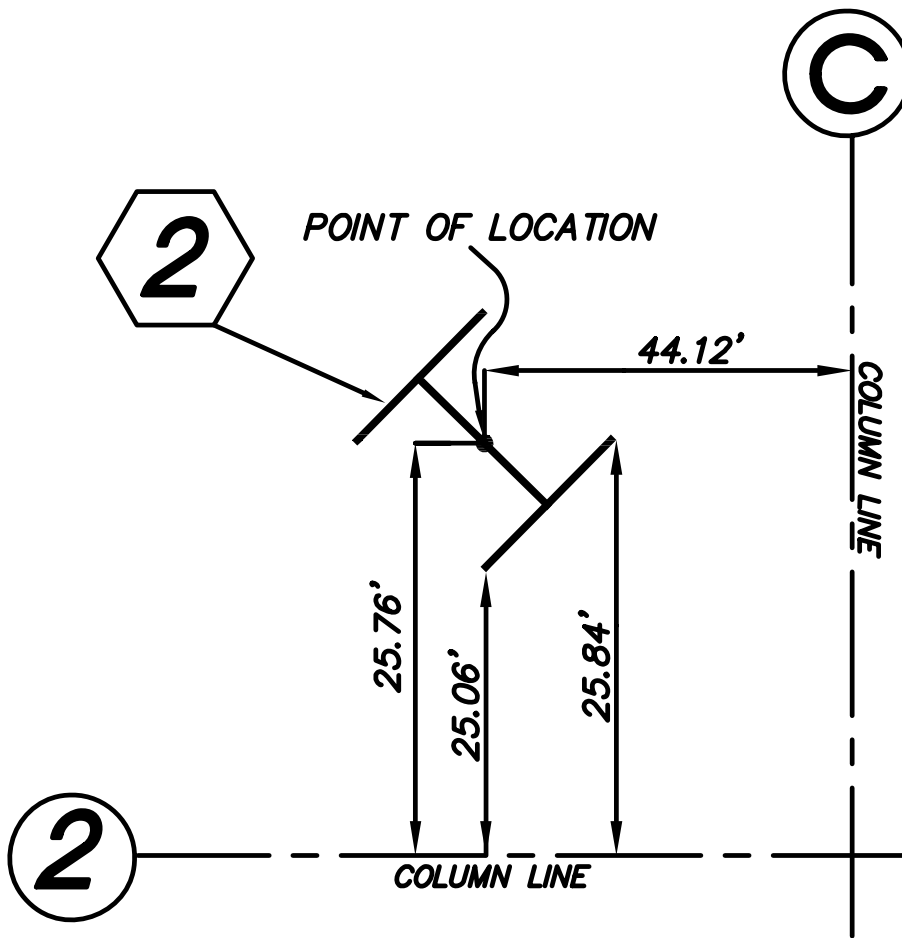

2 PILE NUMBER (TYP)

C COLUMN LINE (TYP)


Prepared by,
BOLDUC LAND CONSULTANTS, LLC
 1237 East Main Street
 Meriden, Connecticut 06450
 Tel: 203-440-1746

PILE 2 LOCATION

10297.58 NORTHING (Y)
 19936.18 EASTING (X)
 12.44 ELEVATION (Z)

**STAMFORD WATER POLLUTION CONTROL FACILITY
SLUDGE DRYING FACILITY
ONE HARBORVIEW AVE
STAMFORD**

**PILE LOCATION. DATE 2/19/07
PREPARED FOR CH2M HILL CONSTRUCTORS, INC.**

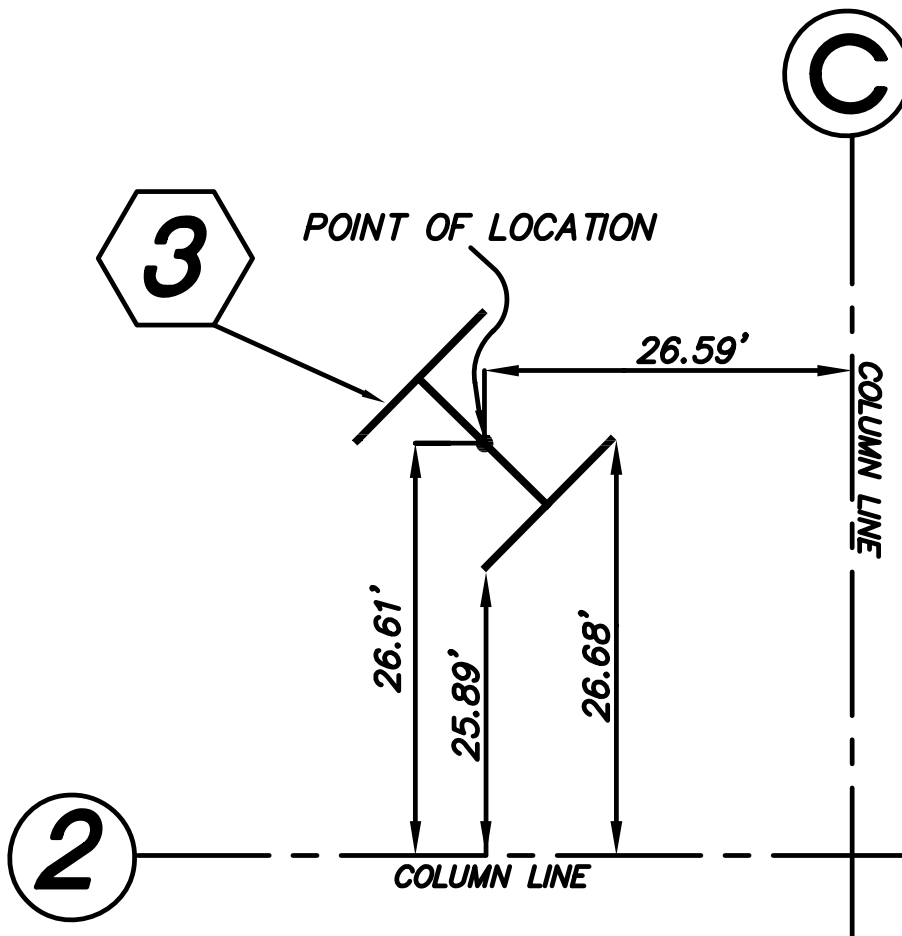

3 PILE NUMBER (TYP)

C COLUMN LINE (TYP)

Prepared by,
BOLDUC LAND CONSULTANTS, LLC
1237 East Main Street
Meriden, Connecticut 06450
Tel: 203-440-1746

PILE 3 LOCATION


10301.33 NORTHING (Y)
19953.33 EASTING (X)
12.49 ELEVATION (Z)

NOT TO SCALE

SHEET 5 OF 20

**STAMFORD WATER POLLUTION CONTROL FACILITY
 SLUDGE DRYING FACILITY
 ONE HARBORVIEW AVE
 STAMFORD**

**PILE LOCATION. DATE 2/19/07
 PREPARED FOR CH2M HILL CONSTRUCTORS, INC.**

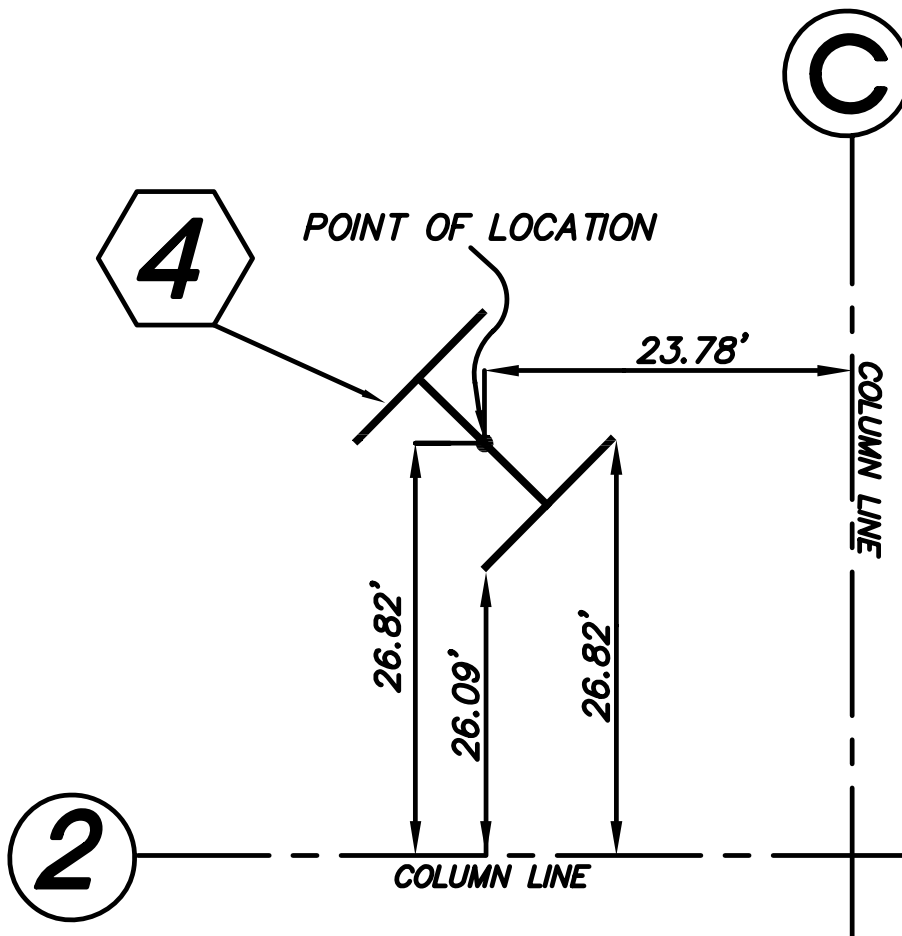

4 PILE NUMBER (TYP)

C COLUMN LINE (TYP)

Prepared by,
BOLDUC LAND CONSULTANTS, LLC
 1237 East Main Street
 Meriden, Connecticut 06450
 Tel: 203-440-1746

PILE 4 LOCATION


10301.99 NORTHING (Y)
 19956.07 EASTING (X)
 12.45 ELEVATION (Z)

NOT TO SCALE

SHEET 6 OF 20

**STAMFORD WATER POLLUTION CONTROL FACILITY
SLUDGE DRYING FACILITY
ONE HARBORVIEW AVE
STAMFORD**

**PILE LOCATION. DATE 2/19/07
PREPARED FOR CH2M HILL CONSTRUCTORS, INC.**

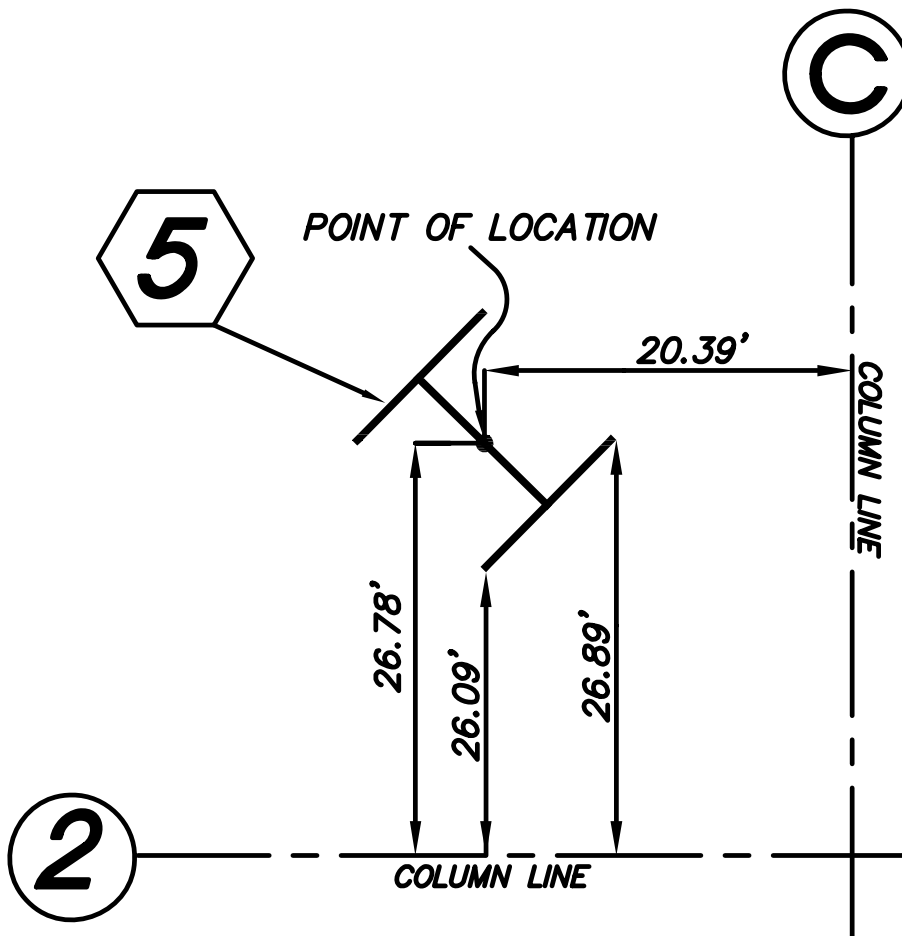

5 PILE NUMBER (TYP)

C COLUMN LINE (TYP)

Prepared by,
BOLDUC LAND CONSULTANTS, LLC
1237 East Main Street
Meriden, Connecticut 06450
Tel: 203-440-1746

PILE 5 LOCATION


10302.52 NORTHING (Y)
19959.42 EASTING (X)
12.45 ELEVATION (Z)

NOT TO SCALE

SHEET 7 OF 20

**STAMFORD WATER POLLUTION CONTROL FACILITY
 SLUDGE DRYING FACILITY
 ONE HARBORVIEW AVE
 STAMFORD**

**PILE LOCATION. DATE 2/19/07
 PREPARED FOR CH2M HILL CONSTRUCTORS, INC.**

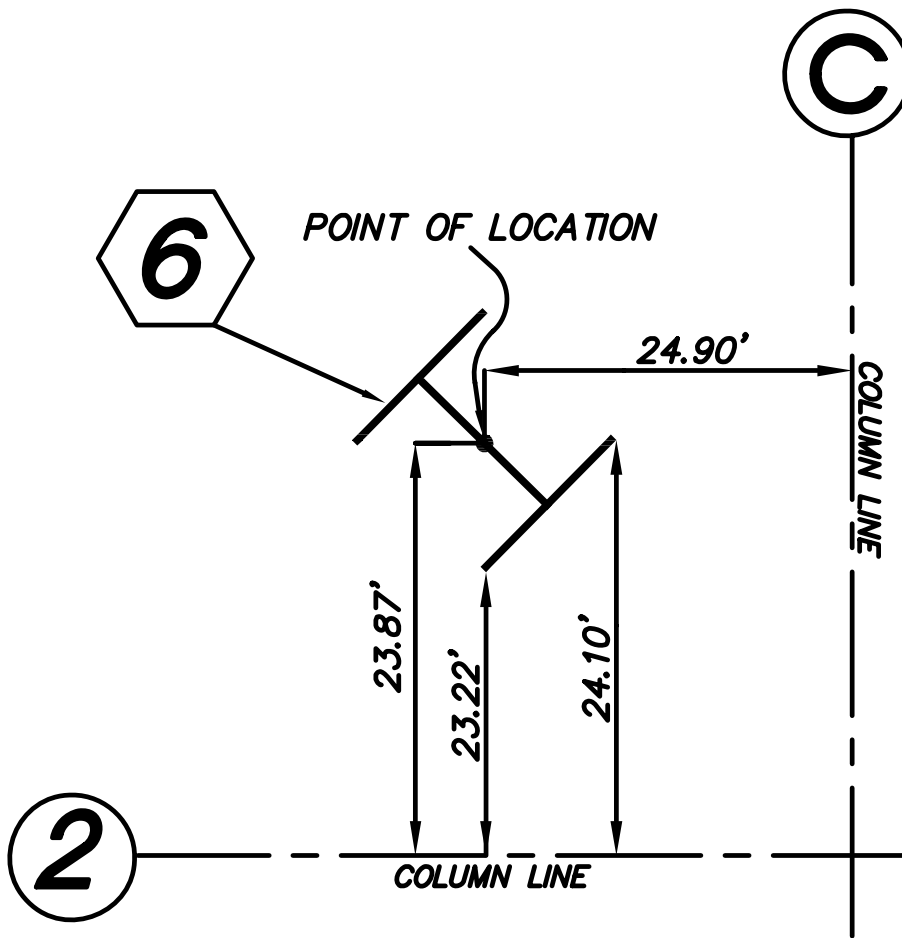

6 PILE NUMBER (TYP)

C COLUMN LINE (TYP)

Prepared by,
BOLDUC LAND CONSULTANTS, LLC
 1237 East Main Street
 Meriden, Connecticut 06450
 Tel: 203-440-1746

PILE 6 LOCATION


10298.90 NORTHING (Y)
 19955.45 EASTING (X)
 12.38 ELEVATION (Z)

NOT TO SCALE

SHEET 8 OF 20

**STAMFORD WATER POLLUTION CONTROL FACILITY
 SLUDGE DRYING FACILITY
 ONE HARBORVIEW AVE
 STAMFORD**

**PILE LOCATION. DATE 2/19/07
 PREPARED FOR CH2M HILL CONSTRUCTORS, INC.**

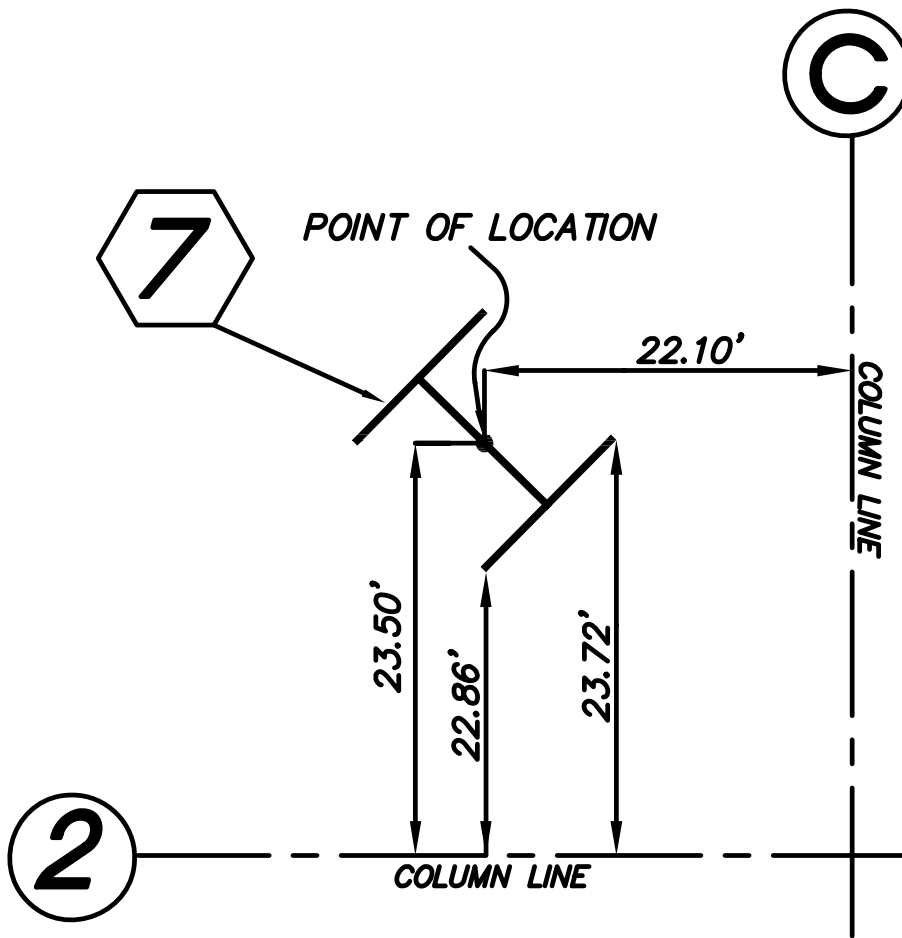

7 PILE NUMBER (TYP)

C COLUMN LINE (TYP)


Prepared by,
BOLDUC LAND CONSULTANTS, LLC
 1237 East Main Street
 Meriden, Connecticut 06450
 Tel: 203-440-1746

PILE 7 LOCATION

10299.00 NORTHING (Y)
 19958.27 EASTING (X)
 12.34 ELEVATION (Z)

**STAMFORD WATER POLLUTION CONTROL FACILITY
 SLUDGE DRYING FACILITY
 ONE HARBORVIEW AVE
 STAMFORD**

**PILE LOCATION. DATE 2/19/07
 PREPARED FOR CH2M HILL CONSTRUCTORS, INC.**

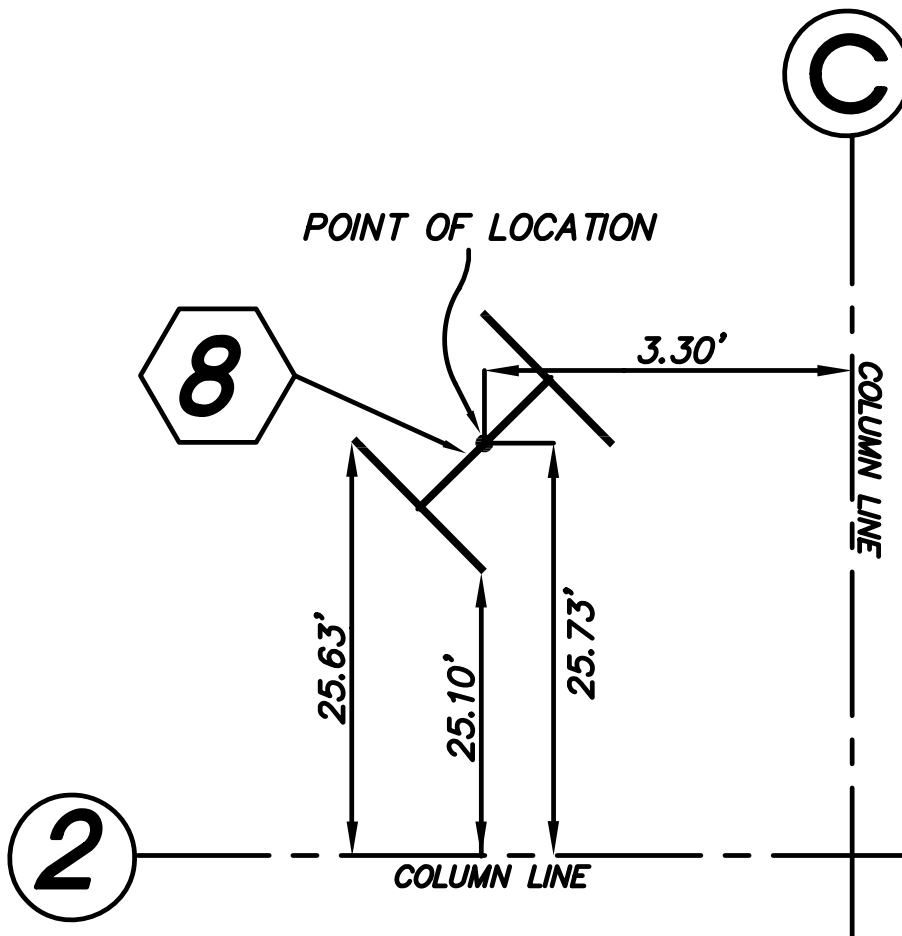

8 PILE NUMBER (TYP)

C COLUMN LINE (TYP)

Prepared by,
BOLDUC LAND CONSULTANTS, LLC
 1237 East Main Street
 Meriden, Connecticut 06450
 Tel: 203-440-1746


PILE 8 LOCATION
 10304.32 NORTHING (Y)
 19976.44 EASTING (X)
 12.47 ELEVATION (Z)



NOT TO SCALE

SHEET 10 OF 20

**STAMFORD WATER POLLUTION CONTROL FACILITY
 SLUDGE DRYING FACILITY
 ONE HARBORVIEW AVE
 STAMFORD**

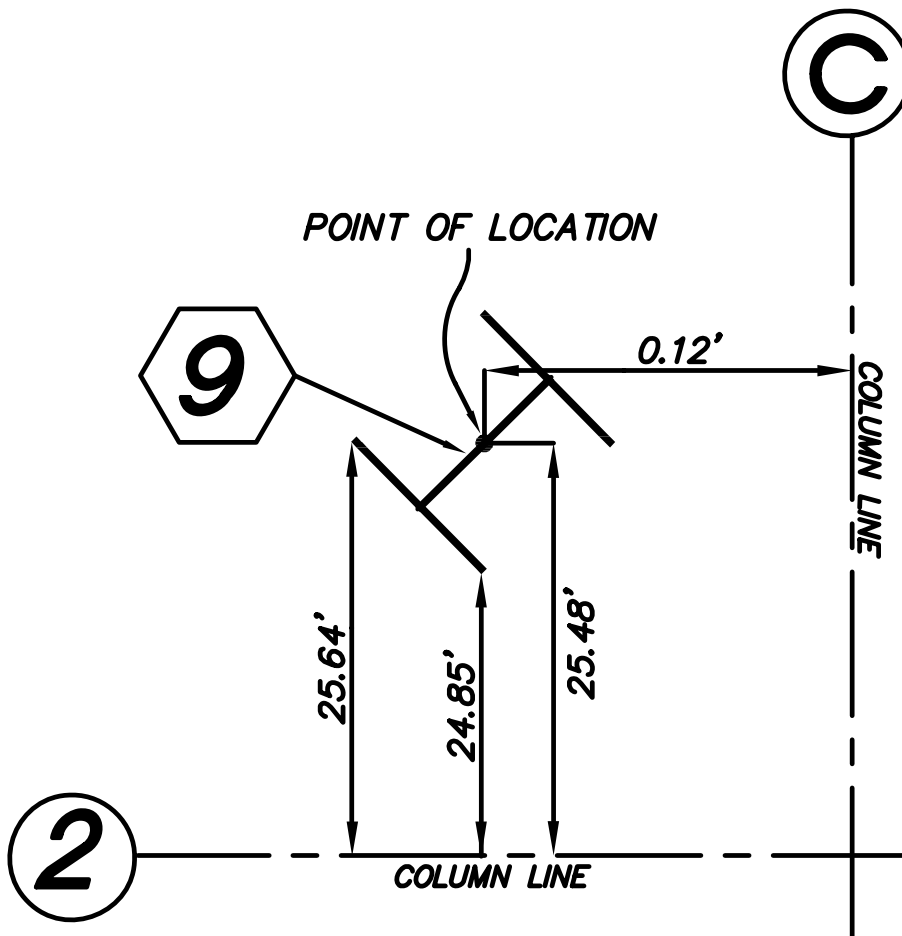**PILE LOCATION. DATE 2/19/07
 PREPARED FOR CH2M HILL CONSTRUCTORS, INC.**



-  PILE NUMBER (TYP)
-  COLUMN LINE (TYP)

Prepared by,
BOLDUC LAND CONSULTANTS, LLC
 1237 East Main Street
 Meriden, Connecticut 06450
 Tel: 203-440-1746


PILE 9 LOCATION
 10304.60 NORTHING (Y)
 19979.62 EASTING (X)
 12.44 ELEVATION (Z)

NOT TO SCALE

SHEET 11 OF 20

**STAMFORD WATER POLLUTION CONTROL FACILITY
 SLUDGE DRYING FACILITY
 ONE HARBORVIEW AVE
 STAMFORD**

**PILE LOCATION. DATE 2/19/07
 PREPARED FOR CH2M HILL CONSTRUCTORS, INC.**

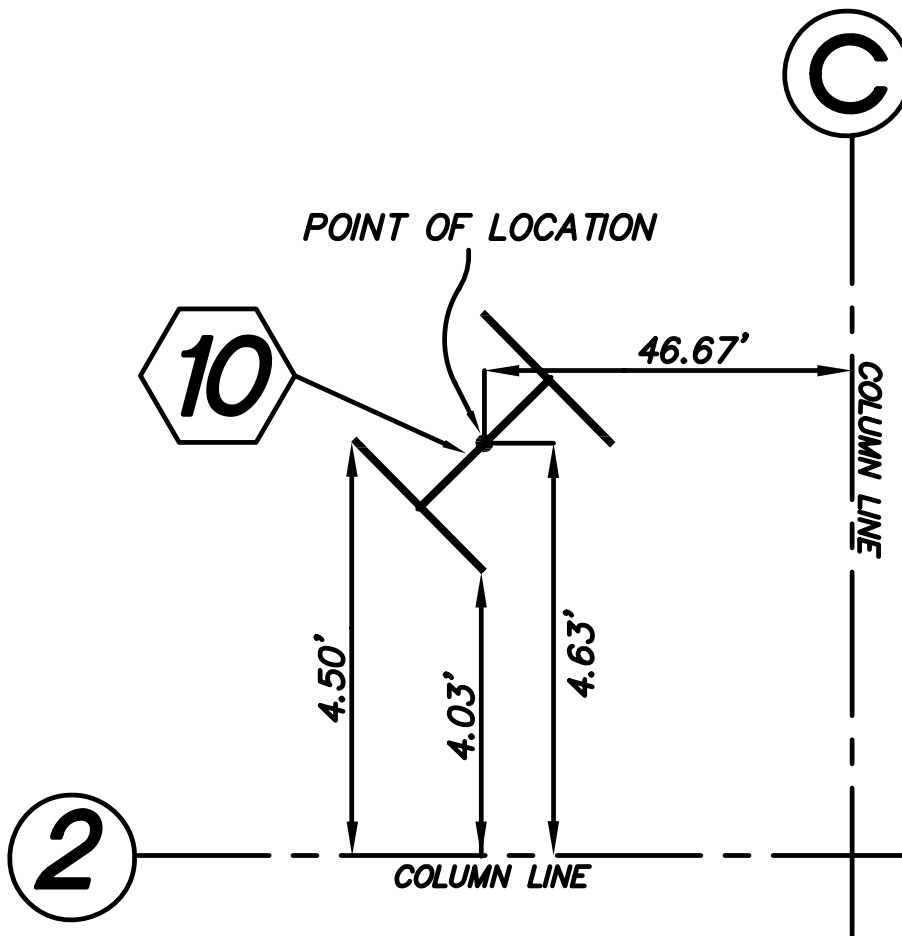

10 PILE NUMBER (TYP)

C COLUMN LINE (TYP)

Prepared by,
BOLDUC LAND CONSULTANTS, LLC
 1237 East Main Street
 Meriden, Connecticut 06450
 Tel: 203-440-1746

PILE 10 LOCATION


10276.32 NORTHING (Y)
 19937.18 EASTING (X)
 12.43 ELEVATION (Z)

NOT TO SCALE

SHEET 12 OF 20

**STAMFORD WATER POLLUTION CONTROL FACILITY
 SLUDGE DRYING FACILITY
 ONE HARBORVIEW AVE
 STAMFORD**

**PILE LOCATION. DATE 2/19/07
 PREPARED FOR CH2M HILL CONSTRUCTORS, INC.**

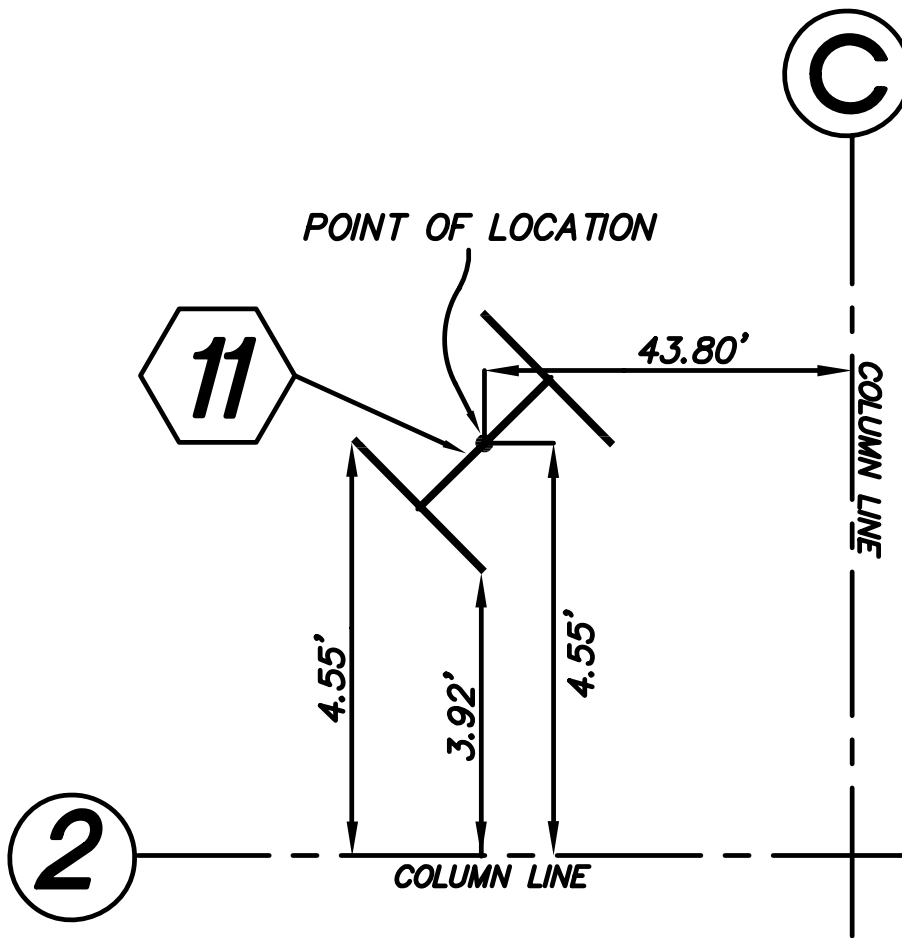

11 PILE NUMBER (TYP)

C COLUMN LINE (TYP)

Prepared by,
BOLDUC LAND CONSULTANTS, LLC
 1237 East Main Street
 Meriden, Connecticut 06450
 Tel: 203-440-1746


PILE 11 LOCATION
 10276.72 NORTHING (Y)
 19940.02 EASTING (X)
 12.45 ELEVATION (Z)

NOT TO SCALE

SHEET 13 OF 20

**STAMFORD WATER POLLUTION CONTROL FACILITY
SLUDGE DRYING FACILITY
ONE HARBORVIEW AVE
STAMFORD**

**PILE LOCATION. DATE 2/19/07
PREPARED FOR CH2M HILL CONSTRUCTORS, INC.**

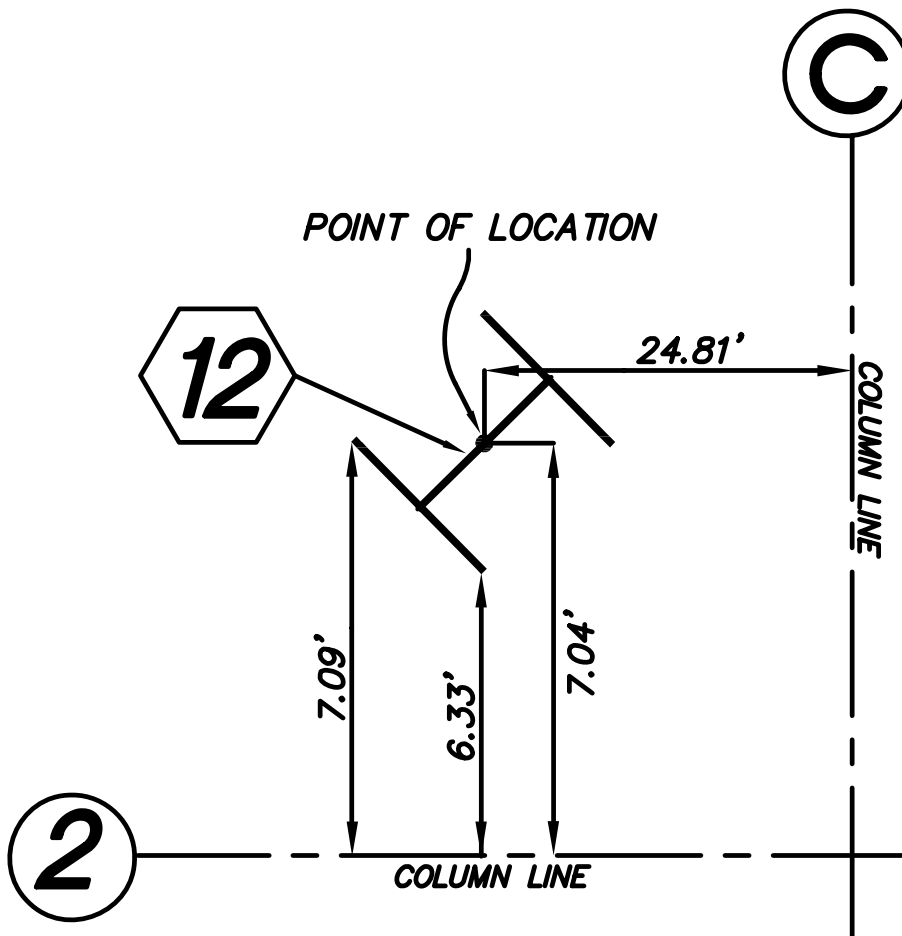

12 PILE NUMBER (TYP)

C COLUMN LINE (TYP)

Prepared by,
BOLDUC LAND CONSULTANTS, LLC
1237 East Main Street
Meriden, Connecticut 06450
Tel: 203-440-1746


PILE 12 LOCATION
10282.32 NORTHING (Y)
19958.33 EASTING (X)
12.45 ELEVATION (Z)

NOT TO SCALE

SHEET 14 OF 20

**STAMFORD WATER POLLUTION CONTROL FACILITY
 SLUDGE DRYING FACILITY
 ONE HARBORVIEW AVE
 STAMFORD**

**PILE LOCATION. DATE 2/19/07
 PREPARED FOR CH2M HILL CONSTRUCTORS, INC.**

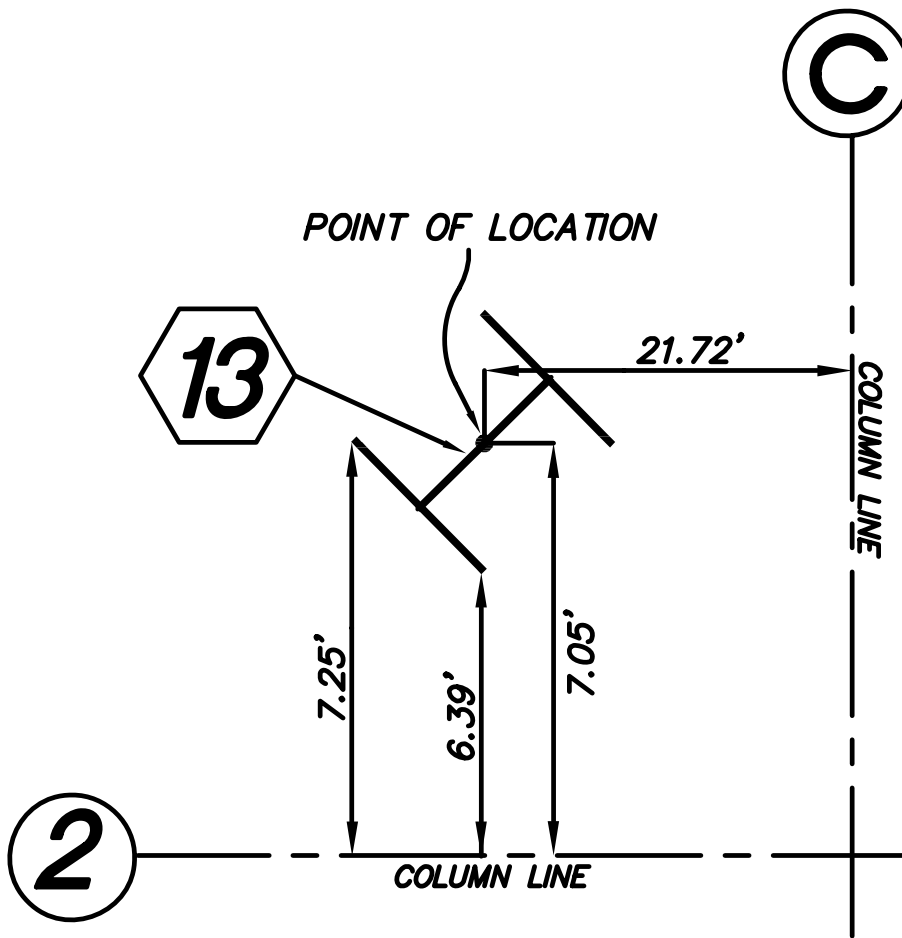

13 PILE NUMBER (TYP)

C COLUMN LINE (TYP)

Prepared by,
BOLDUC LAND CONSULTANTS, LLC
 1237 East Main Street
 Meriden, Connecticut 06450
 Tel: 203-440-1746

PILE 13 LOCATION


10282.84 NORTHING (Y)
 19961.38 EASTING (X)
 12.43 ELEVATION (Z)

NOT TO SCALE

SHEET 15 OF 20

**STAMFORD WATER POLLUTION CONTROL FACILITY
 SLUDGE DRYING FACILITY
 ONE HARBORVIEW AVE
 STAMFORD**

**PILE LOCATION. DATE 2/19/07
 PREPARED FOR CH2M HILL CONSTRUCTORS, INC.**

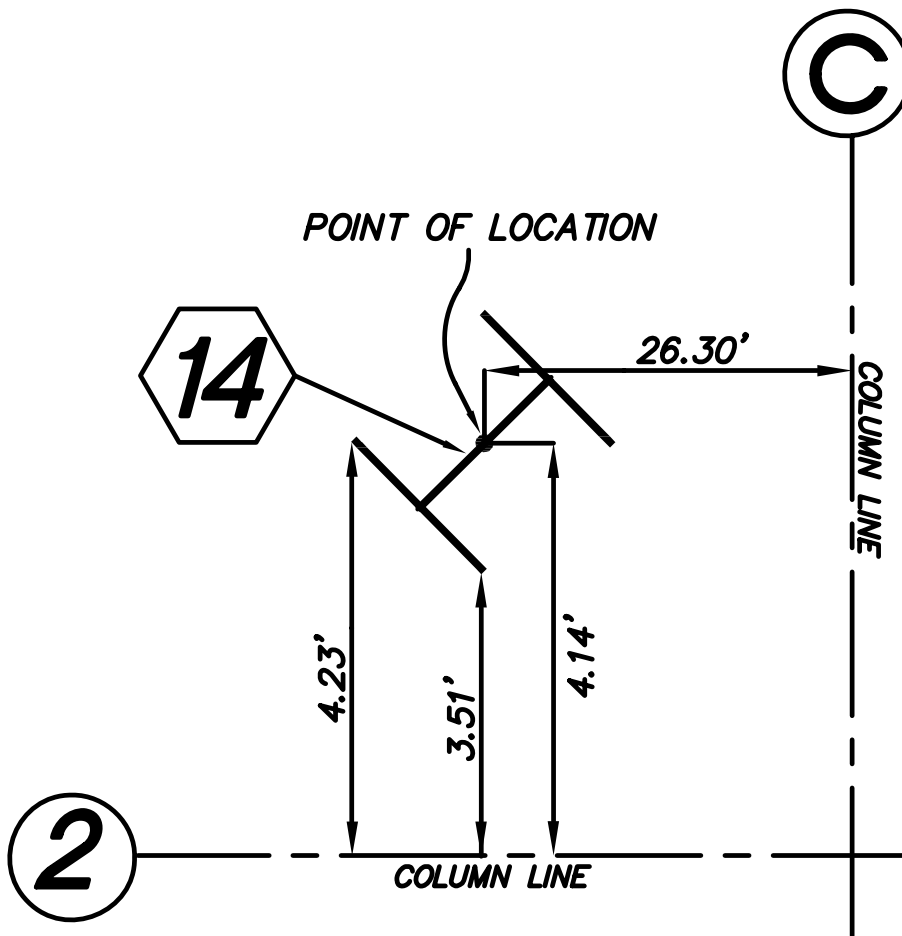

14 PILE NUMBER (TYP)

C COLUMN LINE (TYP)

Prepared by,
BOLDUC LAND CONSULTANTS, LLC
 1237 East Main Street
 Meriden, Connecticut 06450
 Tel: 203-440-1746


PILE 14 LOCATION
 10279.22 NORTHING (Y)
 19957.34 EASTING (X)
 12.45 ELEVATION (Z)

NOT TO SCALE

SHEET 16 OF 20

**STAMFORD WATER POLLUTION CONTROL FACILITY
 SLUDGE DRYING FACILITY
 ONE HARBORVIEW AVE
 STAMFORD**

**PILE LOCATION. DATE 2/19/07
 PREPARED FOR CH2M HILL CONSTRUCTORS, INC.**

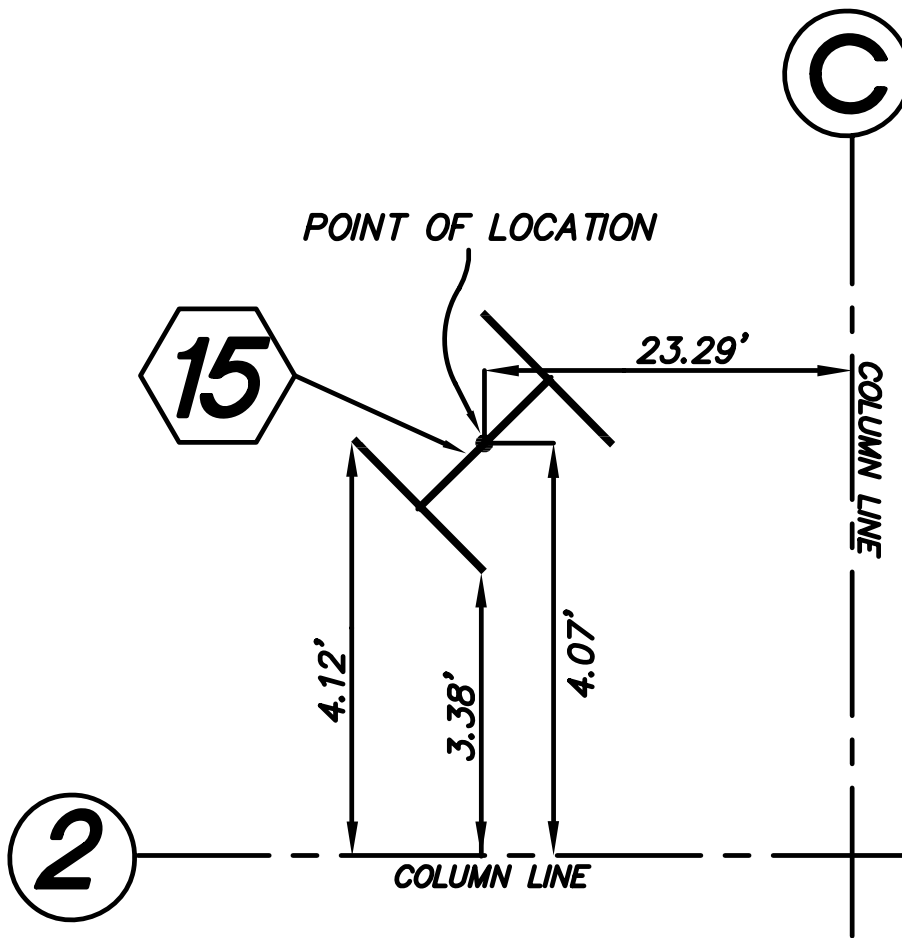

15 PILE NUMBER (TYP)

C COLUMN LINE (TYP)

Prepared by,
BOLDUC LAND CONSULTANTS, LLC
 1237 East Main Street
 Meriden, Connecticut 06450
 Tel: 203-440-1746

PILE 15 LOCATION


10279.64 NORTHING (Y)
 19960.32 EASTING (X)
 12.42 ELEVATION (Z)

NOT TO SCALE

SHEET 17 OF 20

**STAMFORD WATER POLLUTION CONTROL FACILITY
SLUDGE DRYING FACILITY
ONE HARBORVIEW AVE
STAMFORD**

**PILE LOCATION. DATE 2/19/07
PREPARED FOR CH2M HILL CONSTRUCTORS, INC.**

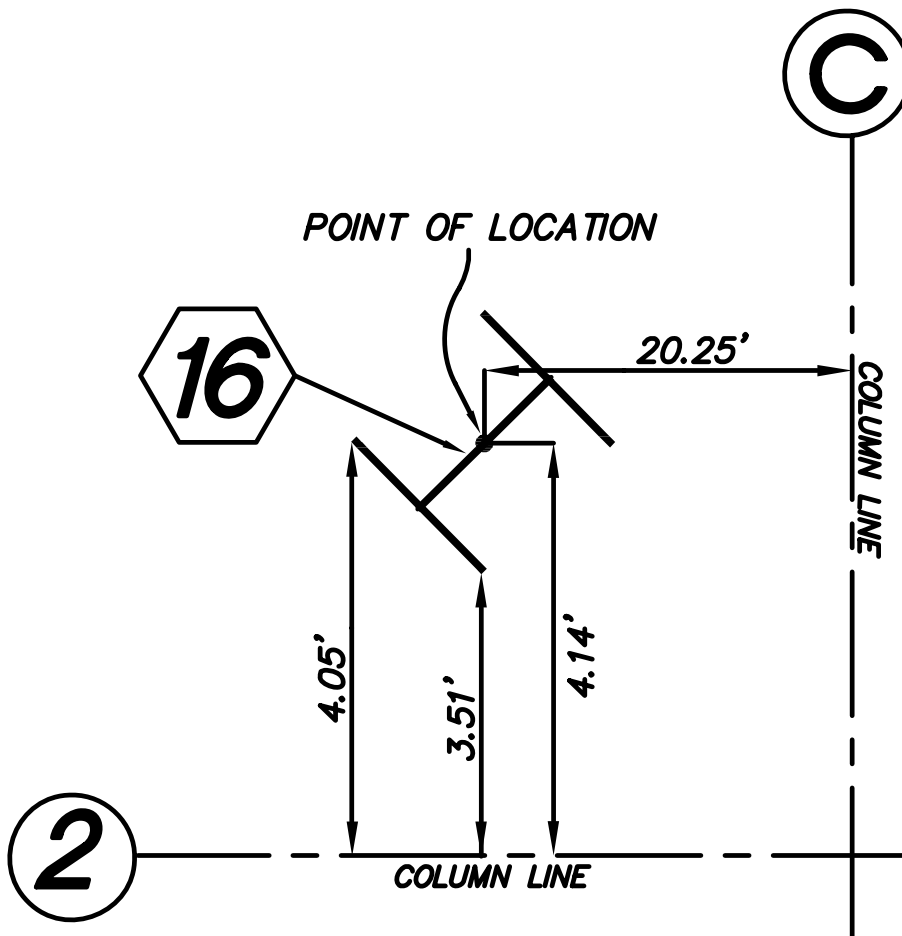

16 PILE NUMBER (TYP)

C COLUMN LINE (TYP)

Prepared by,
BOLDUC LAND CONSULTANTS, LLC
1237 East Main Street
Meriden, Connecticut 06450
Tel: 203-440-1746

PILE 16 LOCATION


10280.21 NORTHING (Y)
19963.30 EASTING (X)
12.37 ELEVATION (Z)

NOT TO SCALE

SHEET 18 OF 20

**STAMFORD WATER POLLUTION CONTROL FACILITY
 SLUDGE DRYING FACILITY
 ONE HARBORVIEW AVE
 STAMFORD**

**PILE LOCATION. DATE 2/19/07
 PREPARED FOR CH2M HILL CONSTRUCTORS, INC.**

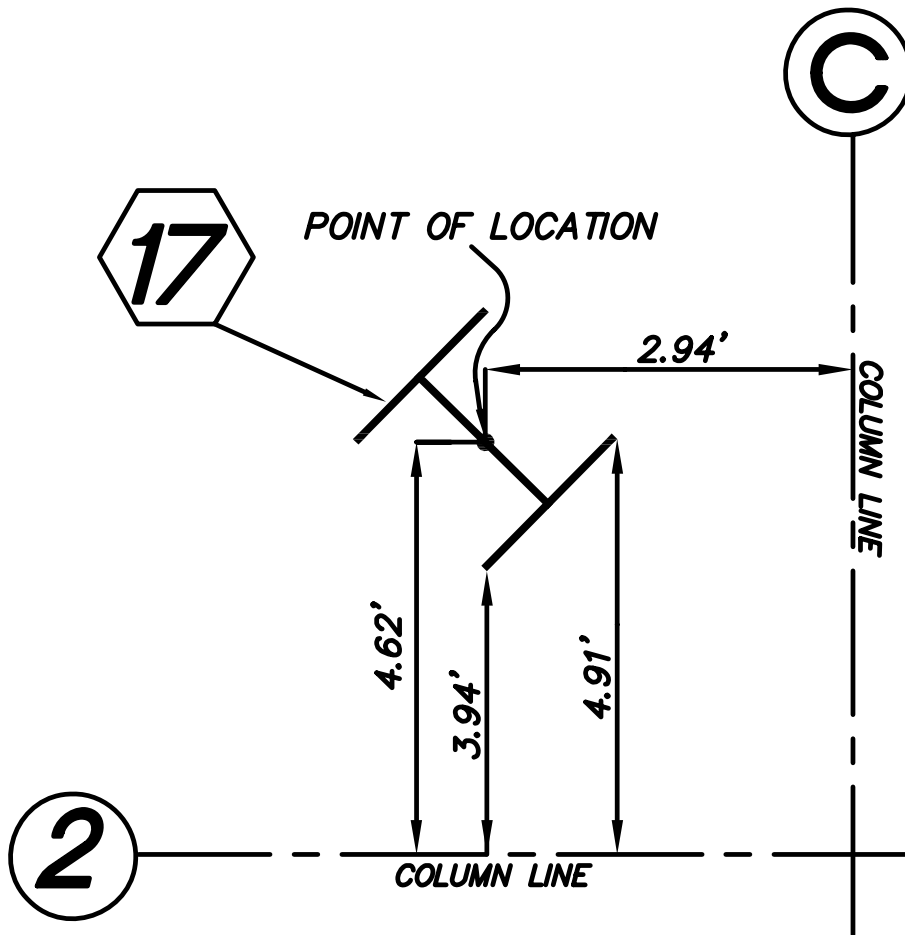

17 PILE NUMBER (TYP)

C COLUMN LINE (TYP)

Prepared by,
BOLDUC LAND CONSULTANTS, LLC
 1237 East Main Street
 Meriden, Connecticut 06450
 Tel: 203-440-1746

PILE 17 LOCATION


10283.56 NORTHING (Y)
 19980.30 EASTING (X)
 12.38 ELEVATION (Z)

NOT TO SCALE

SHEET 19 OF 20

**STAMFORD WATER POLLUTION CONTROL FACILITY
 SLUDGE DRYING FACILITY
 ONE HARBORVIEW AVE
 STAMFORD**

**PILE LOCATION. DATE 2/19/07
 PREPARED FOR CH2M HILL CONSTRUCTORS, INC.**

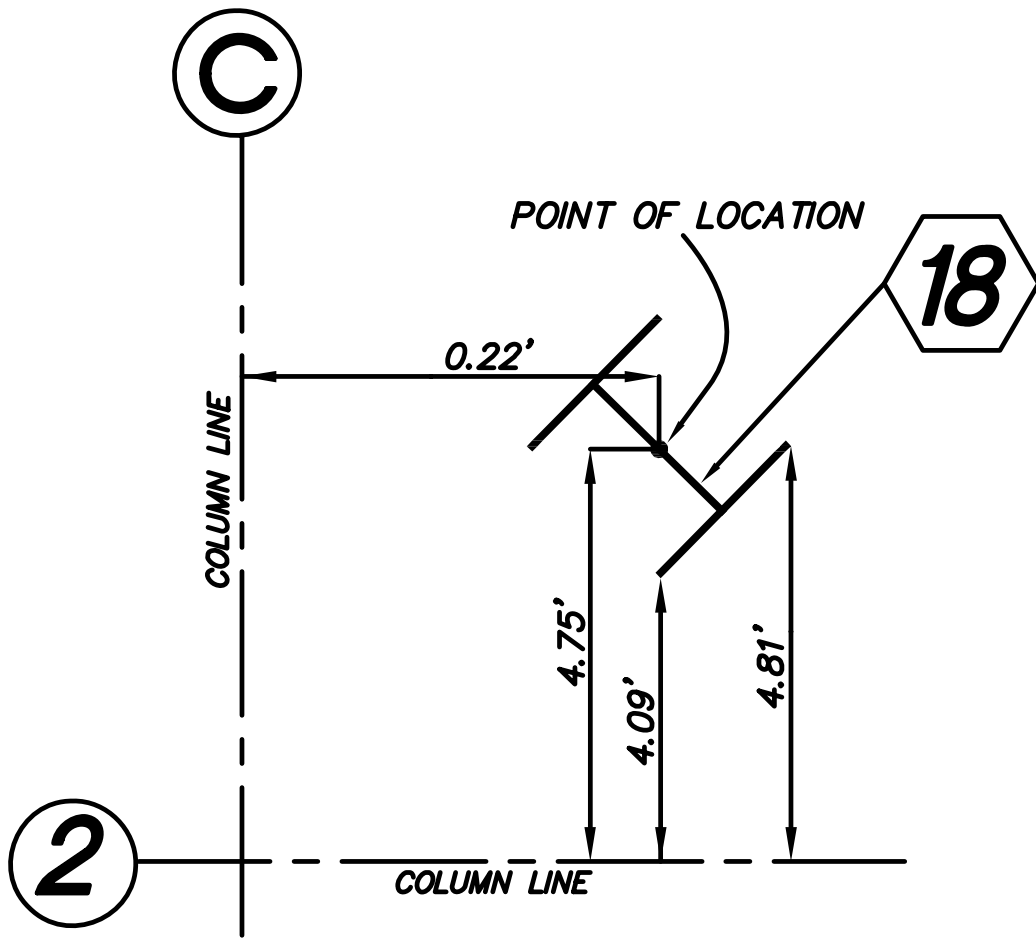

18 PILE NUMBER (TYP)

C COLUMN LINE (TYP)

Prepared by,
BOLDUC LAND CONSULTANTS, LLC
 1237 East Main Street
 Meriden, Connecticut 06450
 Tel: 203-440-1746

PILE 18 LOCATION

10284.21 NORTHING (Y)
 19983.40 EASTING (X)
 12.45 ELEVATION (Z)

NOT TO SCALE

SHEET 20 OF 20